


T. 4 & 5 S. R. 2 W. W. M.

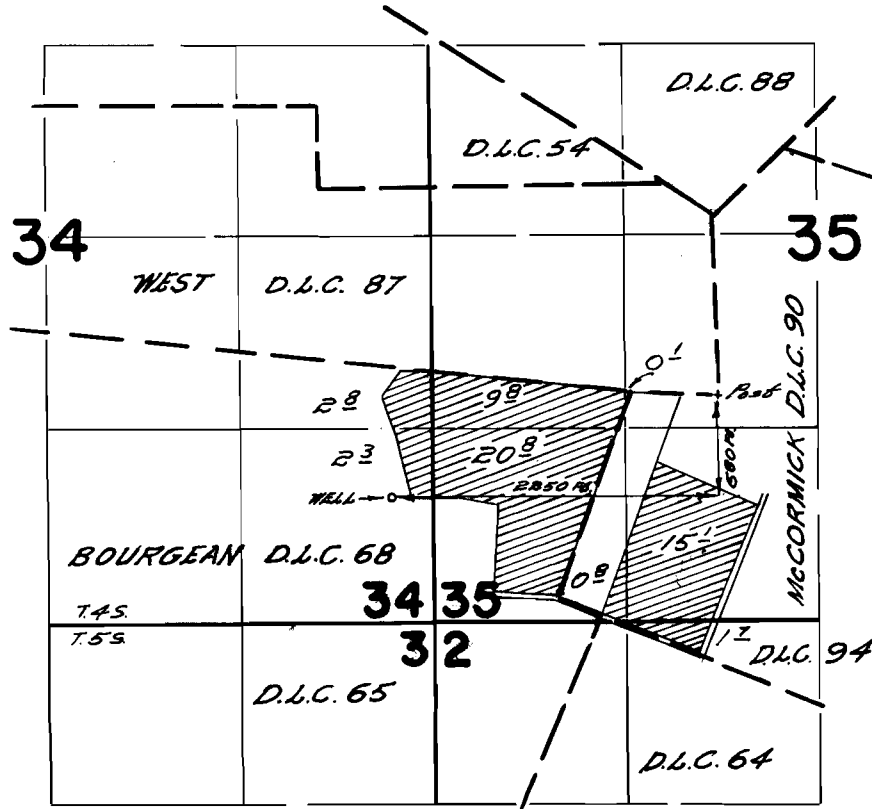

FINAL PROOF SURVEY
UNDER

Application No. G-2925 Permit No. G-2715
IN NAME OF

PATRICK J. JOHNSTON

Surveyed June 18, 1968, by W. J. Ruppert