


T.5S.R.1W.W.M.

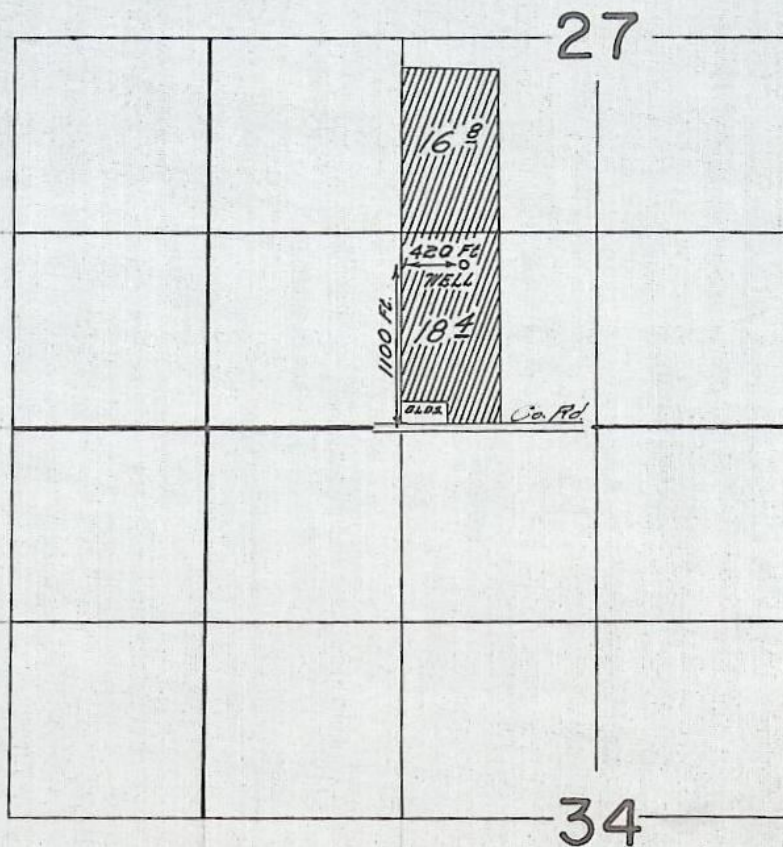

FINAL PROOF SURVEY
UNDER

Application No. *G-3080* Permit No. *G-2867*
IN NAME OF

OTTO J. ERWERT

Surveyed *April 10 1968*, by *W. J. Ruppberg*