T. 4 & 5 S. R. 1 W. W. M.

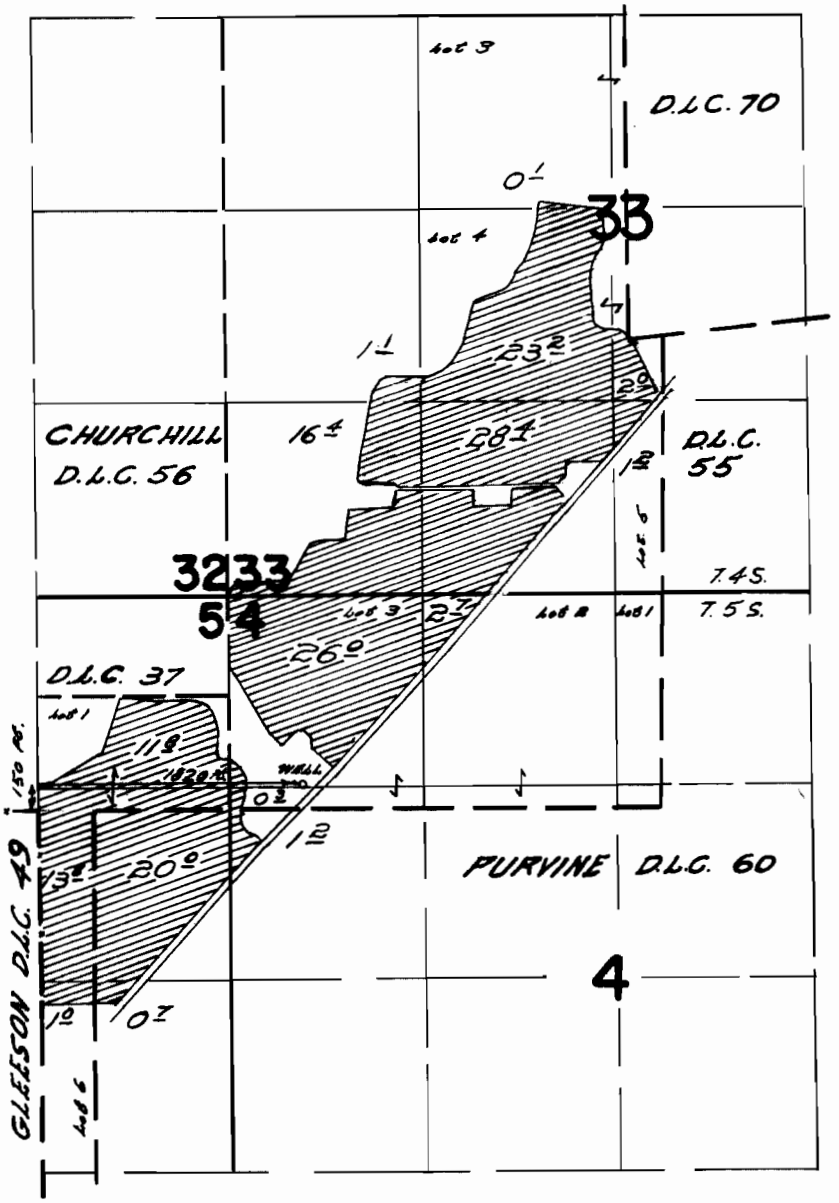

FINAL PROOF SURVEY
UNDER

Application No. G-3081 Permit No. G-2878
IN NAME OF

BRONEC BROTHERS

Surveyed MAY 10 1968, by W. J. Ruppert

1968-K DFN-20211