


# T.4 S. R.1 W.W.M.

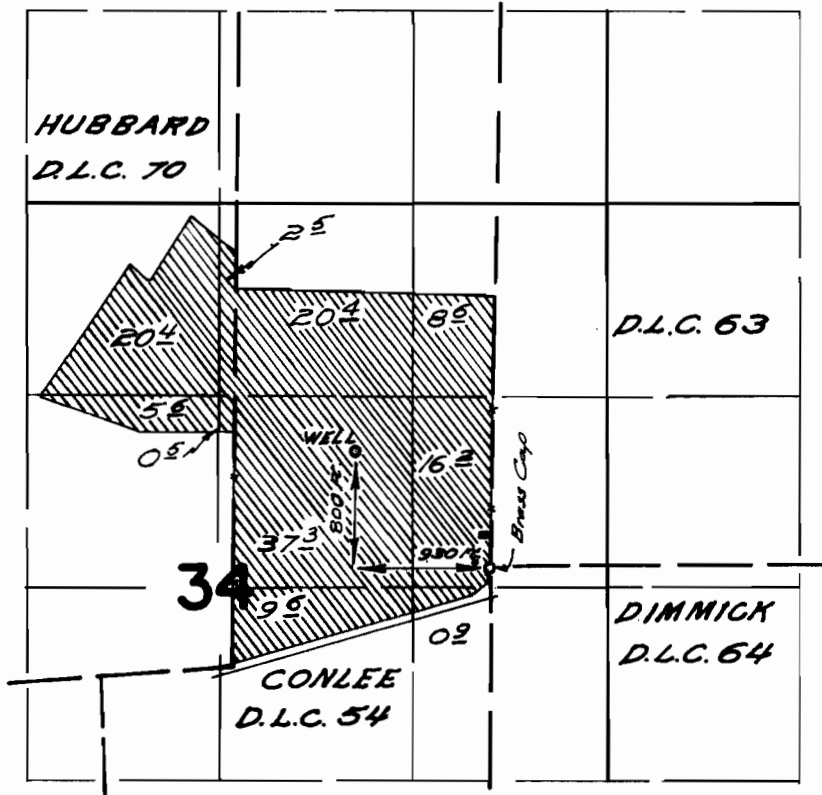

## FINAL PROOF SURVEY UNDER

Application No. *G-3147*. Permit No. *G-2964*  
IN NAME OF

*ROLAND L. KUENZI*

Surveyed *May 8, 1968*, by *W. d. Ruppert*