T. 5S. R. 1 W.W.M.

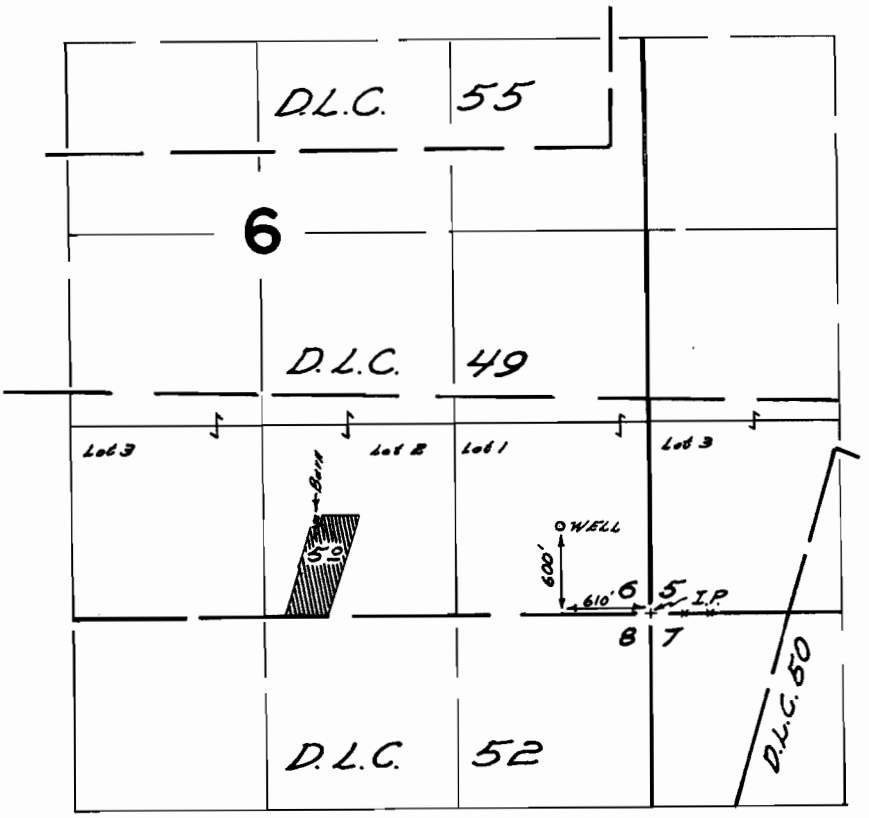

FINAL PROOF SURVEY
UNDER

Application No. G-3533 Permit No. G-3325
IN NAME OF

VERA J. SEIME

Surveyed April 11 1968, by W. L. Ruppert

1968-J