


T.4S. R.1W. W.M.

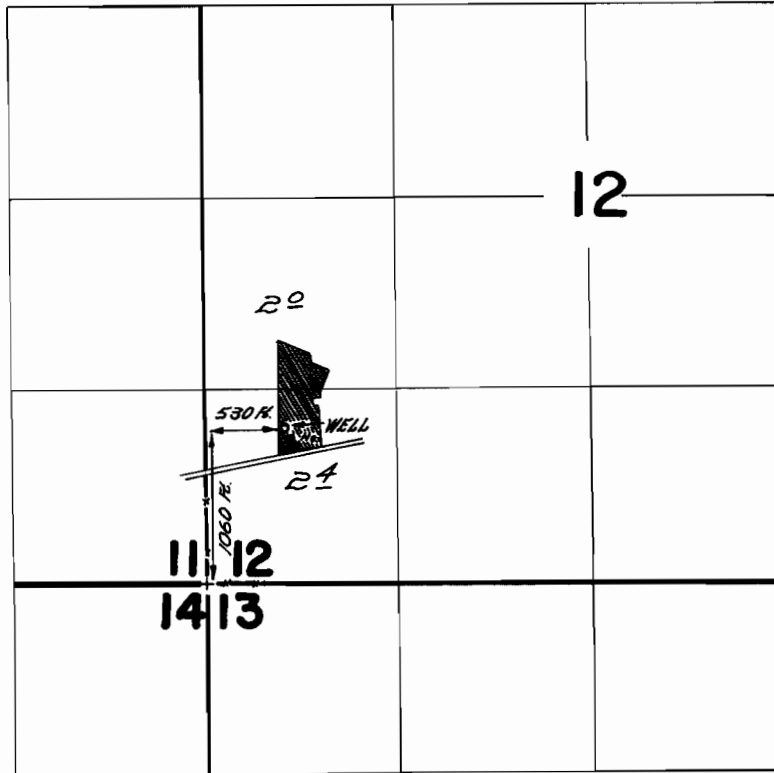

FINAL PROOF SURVEY
UNDER

Application No. *G-3571* Permit No. *G-3365*
IN NAME OF

GEORGE H. WIEDERHOLD

Surveyed *May 29 1968*, by *M. A. Rupperts*