


T.4&5S.R.2&3W.W.M.

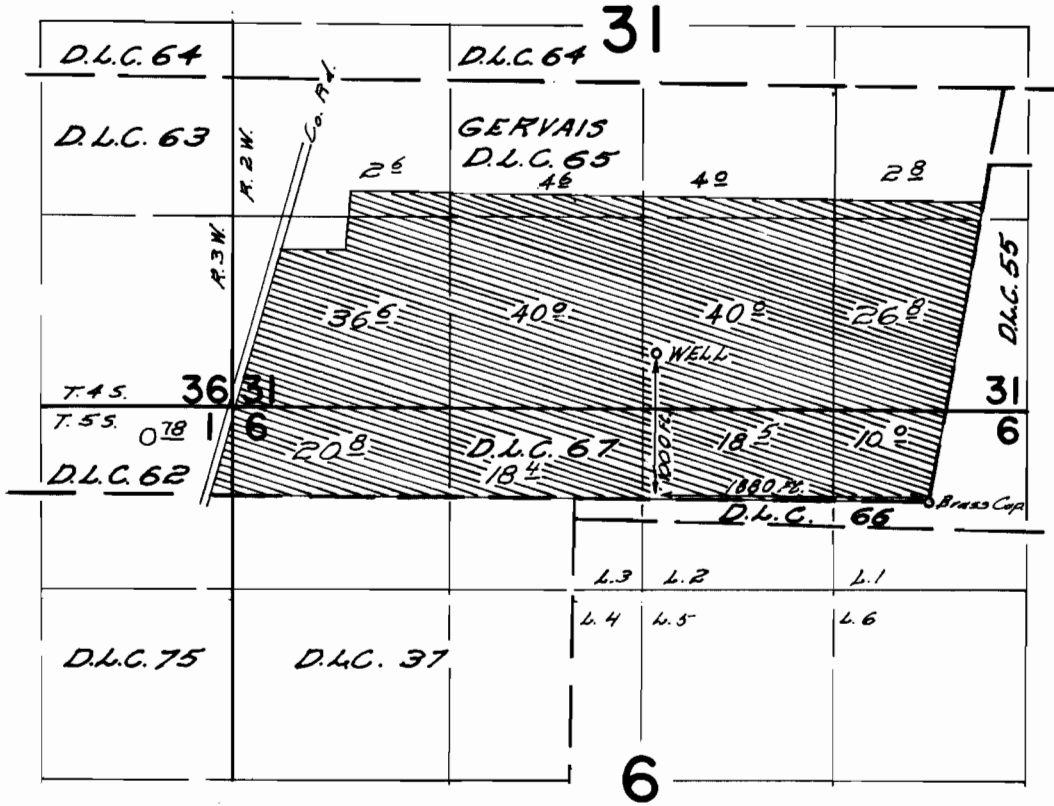

FINAL PROOF SURVEY UNDER

Application No. *G-3544* Permit No. *G-3479*
IN NAME OF

RALPHA A. CASE

Surveyed *April 19 1968*, by *N.J. Ruppert*