


T. 4 S. R. 2 W. W. M.

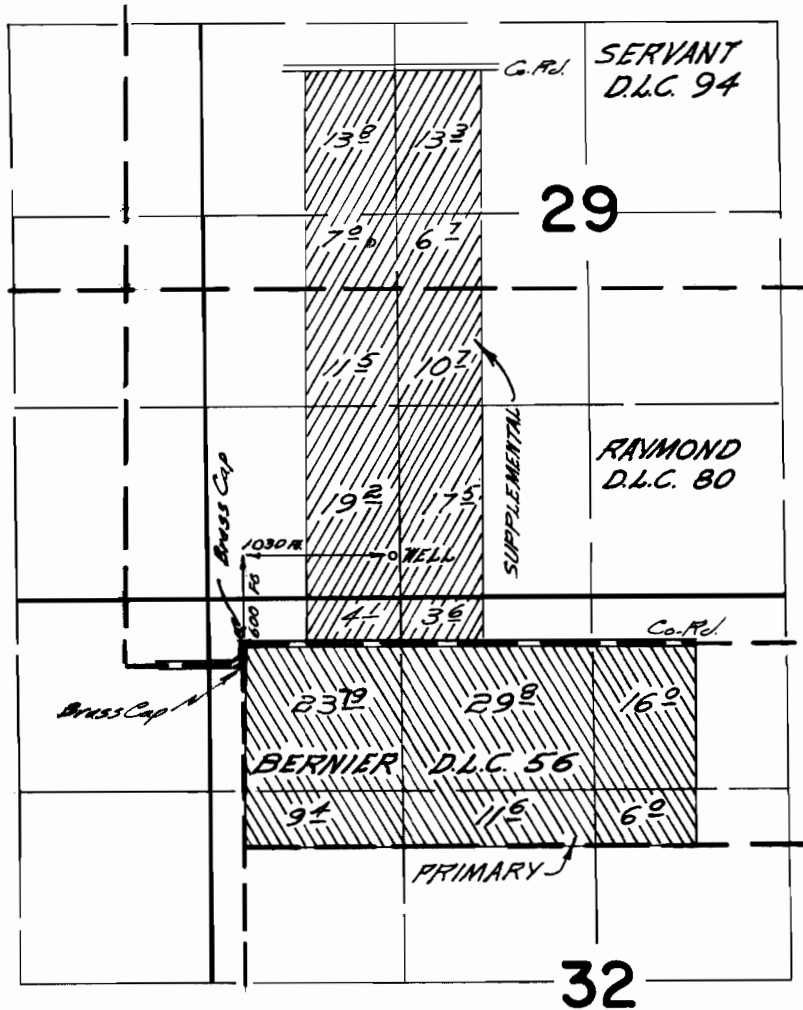

FINAL PROOF SURVEY
UNDER

Application No. *G-3768* Permit No. *G-3554*
IN NAME OF

RAYMOND T. DAVIDSON

Surveyed *June 18, 1968*, by *W. V. Rupperts*