


T. 5S. R. 1W. W.M.

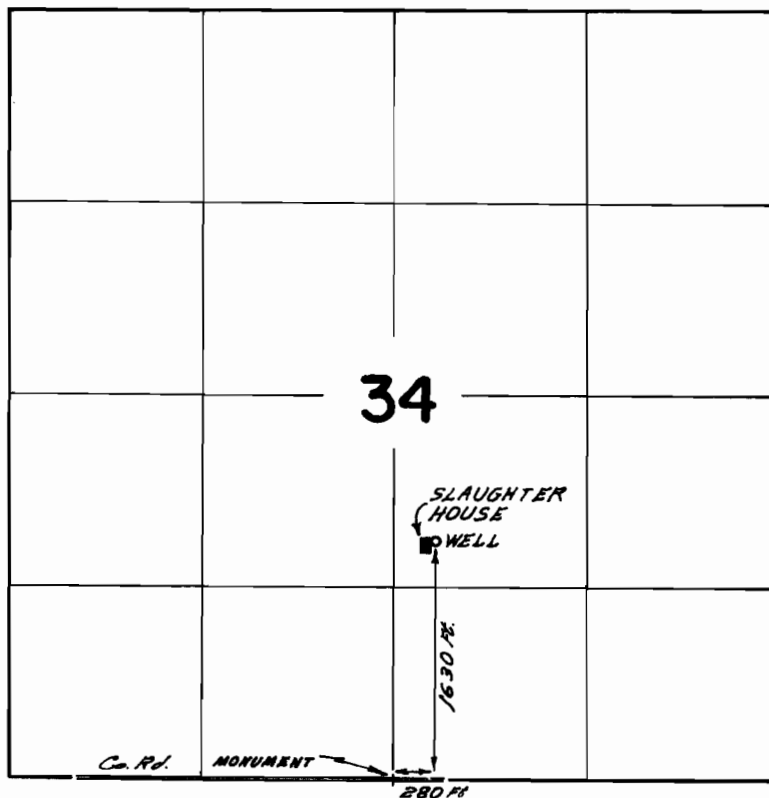

FINAL PROOF SURVEY
UNDER

Application No. G-3799 Permit No. G-3585
IN NAME OF

ALBERT & ANGELA EBNER

Surveyed April 11, 1968, by W. J. Puppert