


T.5S.R.2W.W.M.

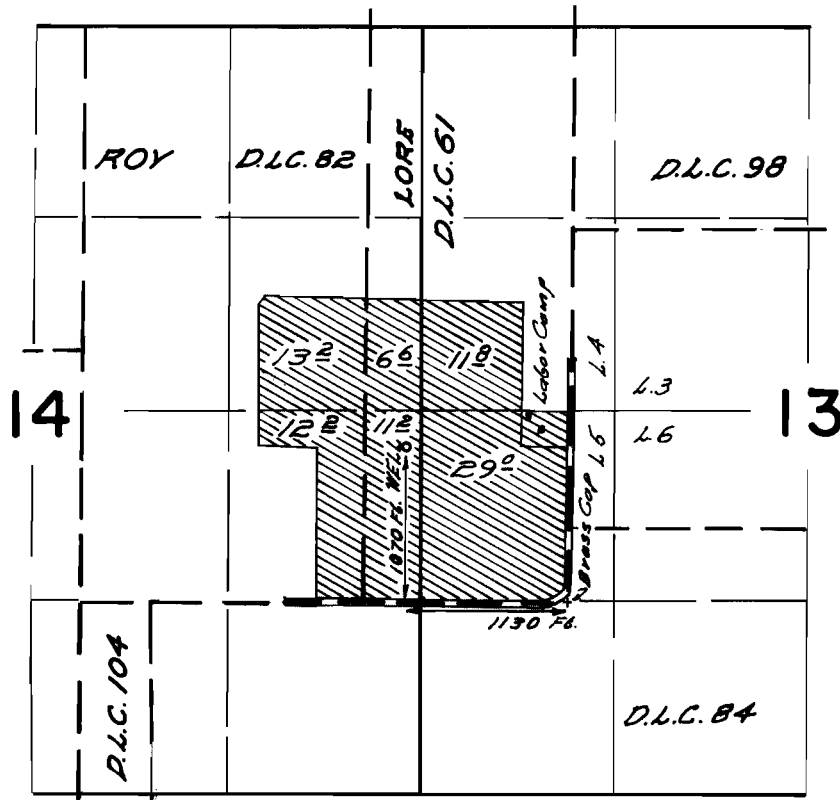

FINAL PROOF SURVEY UNDER

Application No. G-3901 Permit No. G-3666
IN NAME OF

P.J. WILLARD

Surveyed April 12, 1968, by W.J. Ruppert