


T. 4 S. R. 2 W. W.M.

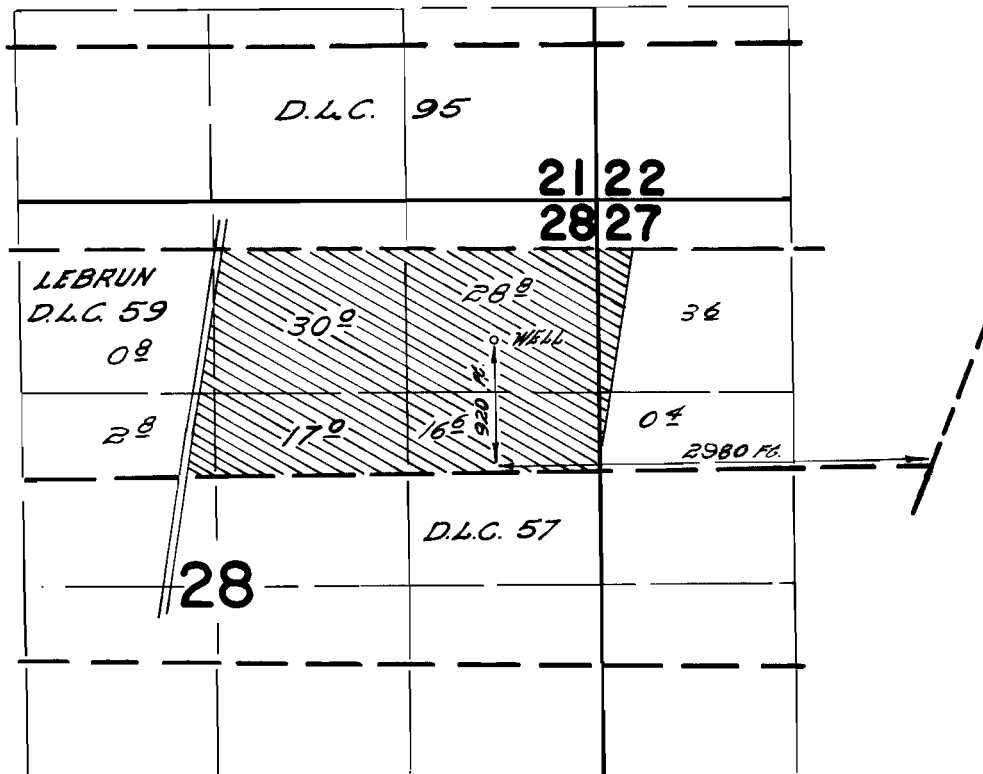

FINAL PROOF SURVEY
UNDER

Application No. G-4249 Permit No. G-3818
IN NAME OF

ARTHUR MCKAY

Surveyed May 31, 1968, by W.C. Ruppert