


T.9 S. R.2W. W.M.

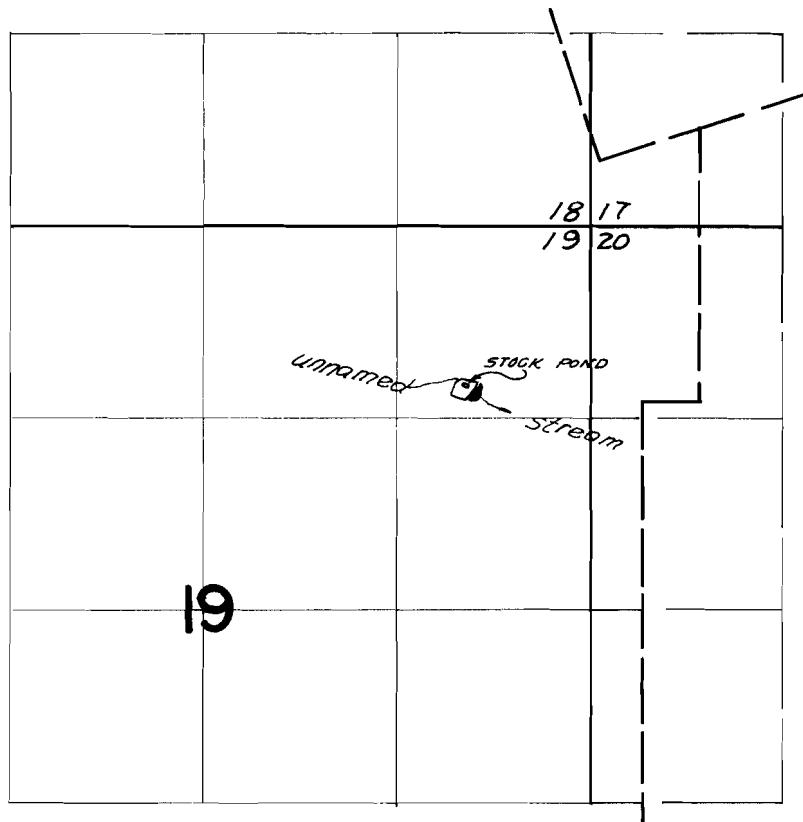

FINAL PROOF SURVEY
UNDER

Application No. *R-42606* Permit No. *R-4834*
IN NAME OF

CHESTER R. STACKHOUSE

Surveyed *July 2 1968*, by *V. Garner*