


T.4S. R.1W.W.M.

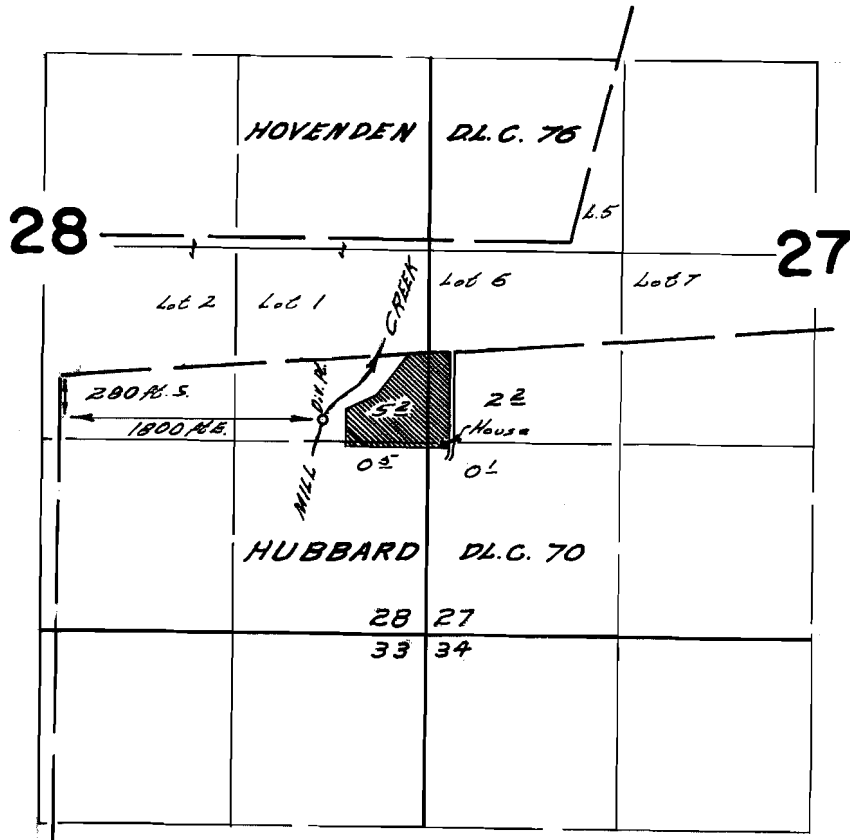

FINAL PROOF SURVEY UNDER

Application No. 40029 Permit No. 22813
IN NAME OF

GEORGE A. WADDINGTON

Surveyed May 8, 1968, by W. J. Ruppert, Jr.