


T. 10S. R. 2W. W.M.

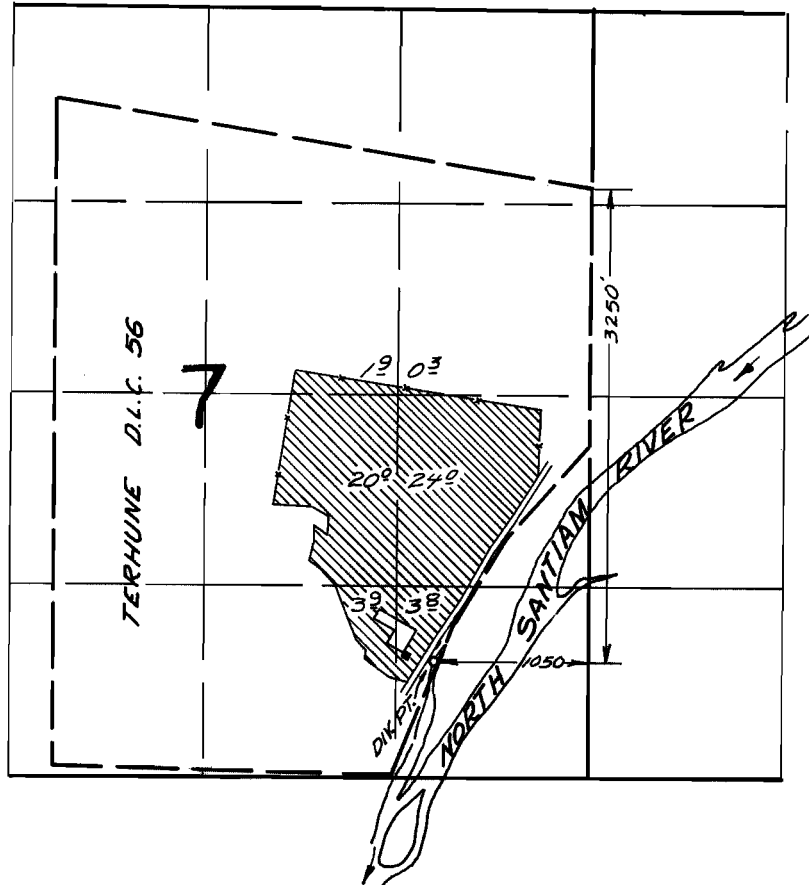

FINAL PROOF SURVEY
UNDER

Application No. 40703 Permit No. 30320
IN NAME OF

FRANK D. and NORA L. MORRIS

Surveyed July 23, 1968, by V. Garner