


T.9S. R.2W. W.M.

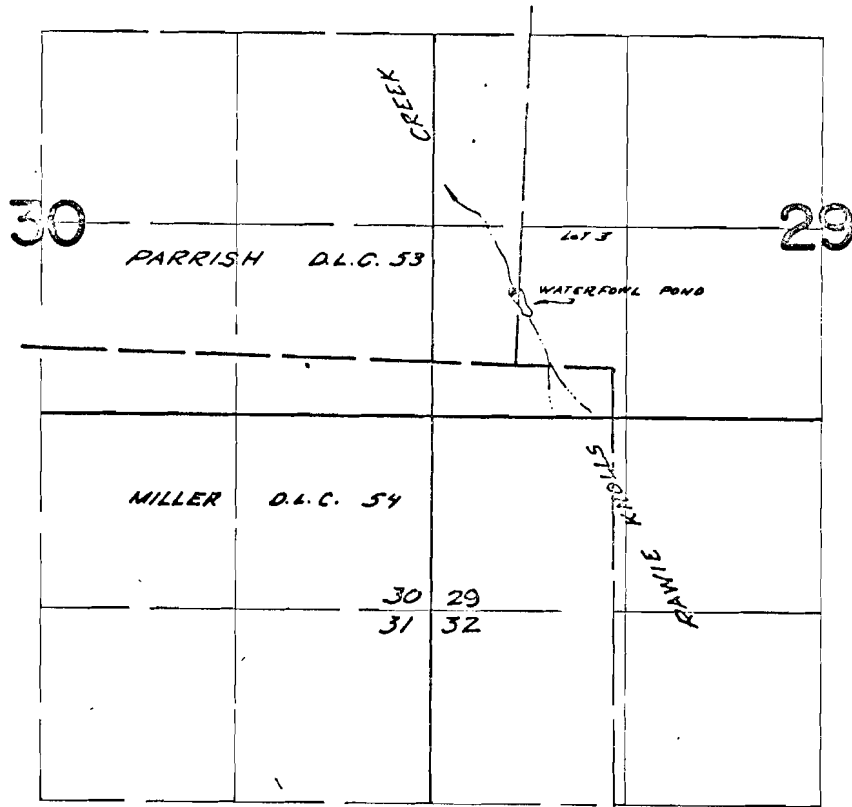

Div. pt. located 500 ft. N. & 20 ft. W. from
the S.E. cor. PARRISH D.L.C. 53

FINAL PROOF SURVEY
UNDER

R-43549 R-4861
Application No. 43550... Permit No. 31955...
IN NAME OF

..... LENORA RAWIE

Surveyed July 1, 1968, by V. Garner.....