


T. 4S. R. 2W. W.M.

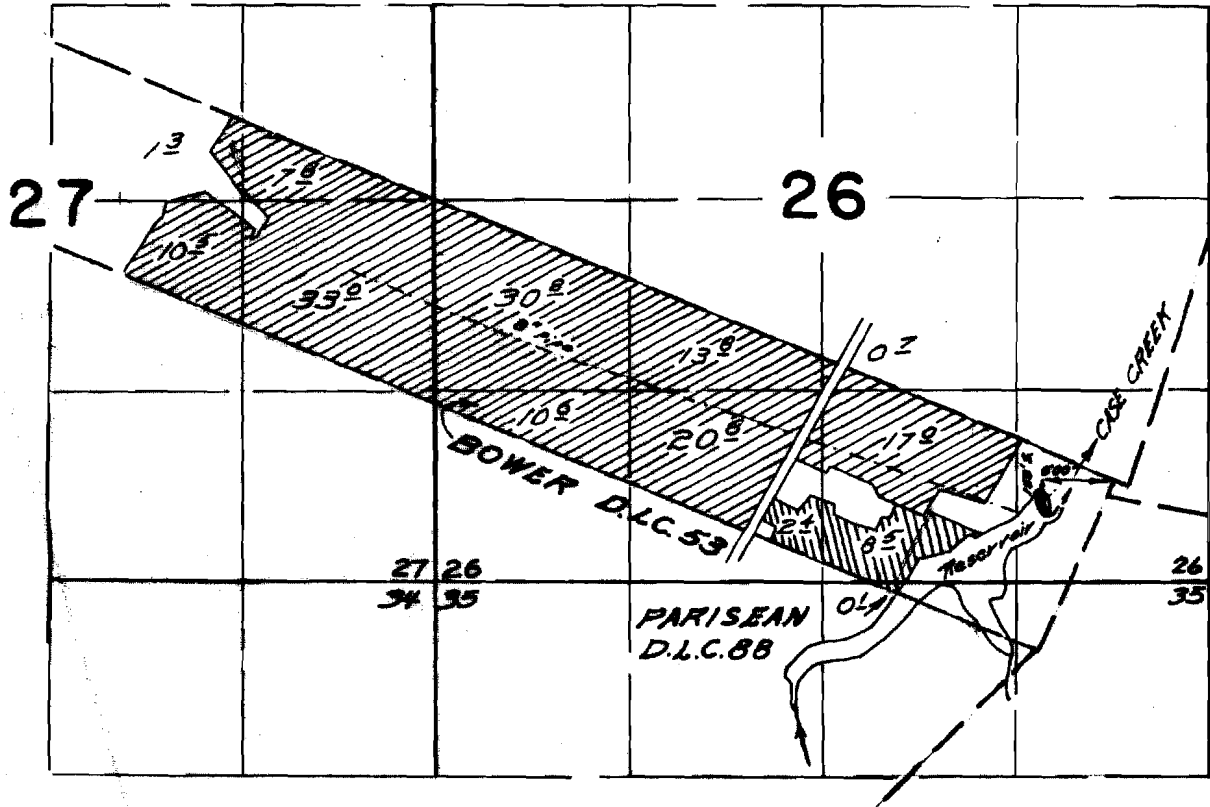

FINAL PROOF SURVEY
UNDER

Application No. *R-43897* Permit No. *R-4943*
42113 *32258*
IN NAME OF

NEAL W. MILLER

Surveyed *June 7* 1968 by *M. J. Boppert*