


T.4S.R.2W.W.M.

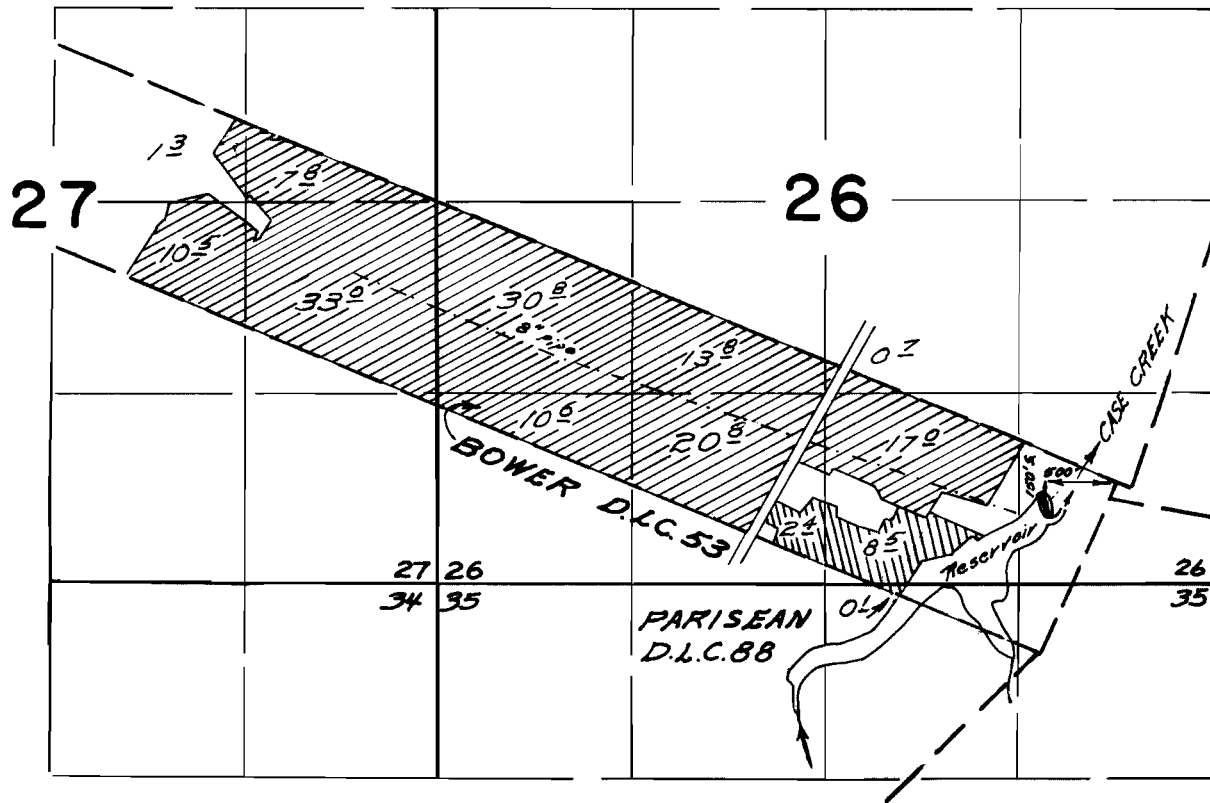

FINAL PROOF SURVEY
UNDER

R-43897 R-4943
Application No. 42113 Permit No. 32258
IN NAME OF

NEAL W. MILLER

Surveyed June 7 1968 by W. J. Ruppert