


T.4S. R.3W. W.M.

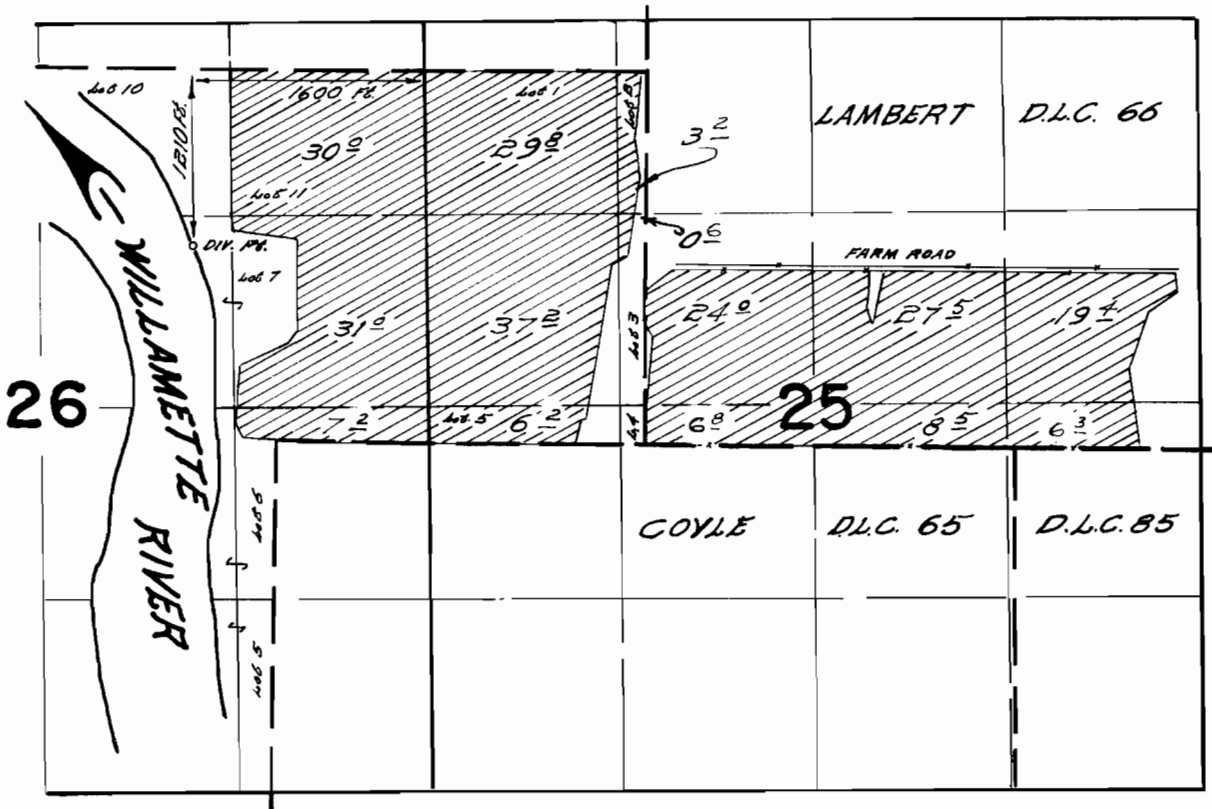

FINAL PROOF SURVEY
UNDER

Application No. 43239 Permit No. 32325
IN NAME OF

JEROME J. SMITH

Surveyed date 17. 19.68, by *W.D. Ruppert*.