
T.9S. R.4W. W.M.

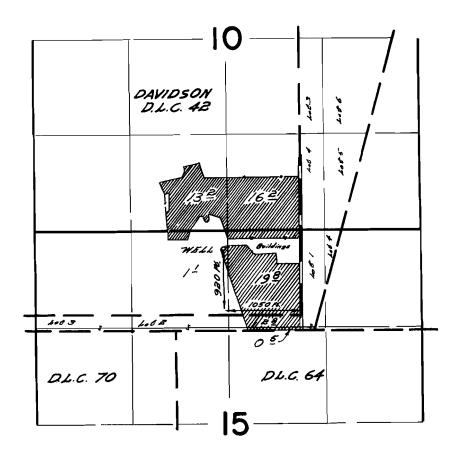

FINAL PROOF SURVEY

Application No. G-2887. Permit No. G-2676 IN NAME OF

PAUL L. MURPHY

Surveyed Aug. 13. 1968, by W.d. Ruppert