


T.8S. R.6W. W.M

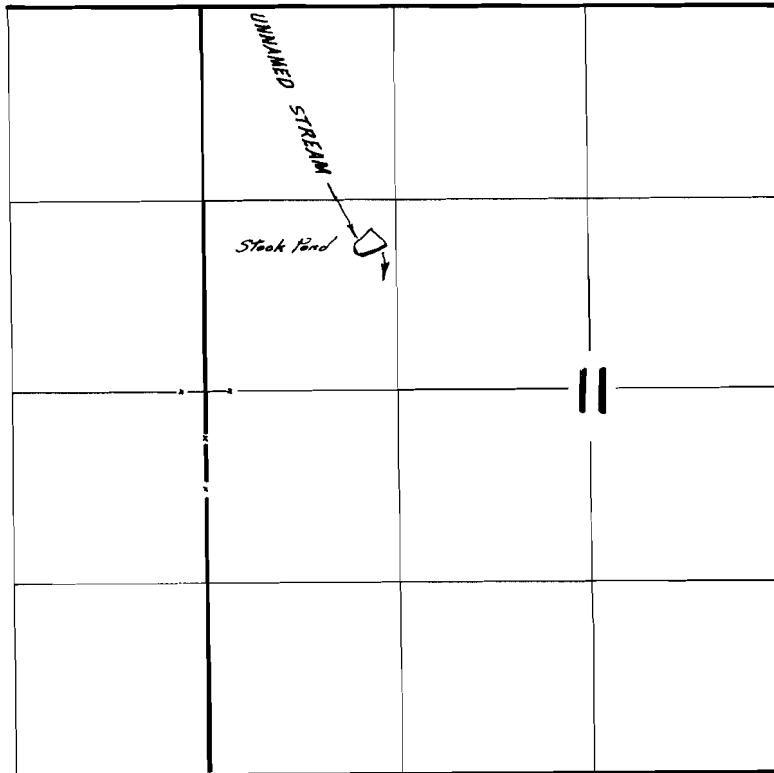

FINAL PROOF SURVEY
UNDER

Application No. *R-43059* Permit No. *R-4819*

IN NAME OF

CHARLES L. & DOROTHY M. MCLOUD

Surveyed *Sept. 25, 1968*, by *W. J. Ruppert*