


T. 7 S. R. 4 W. W.M.

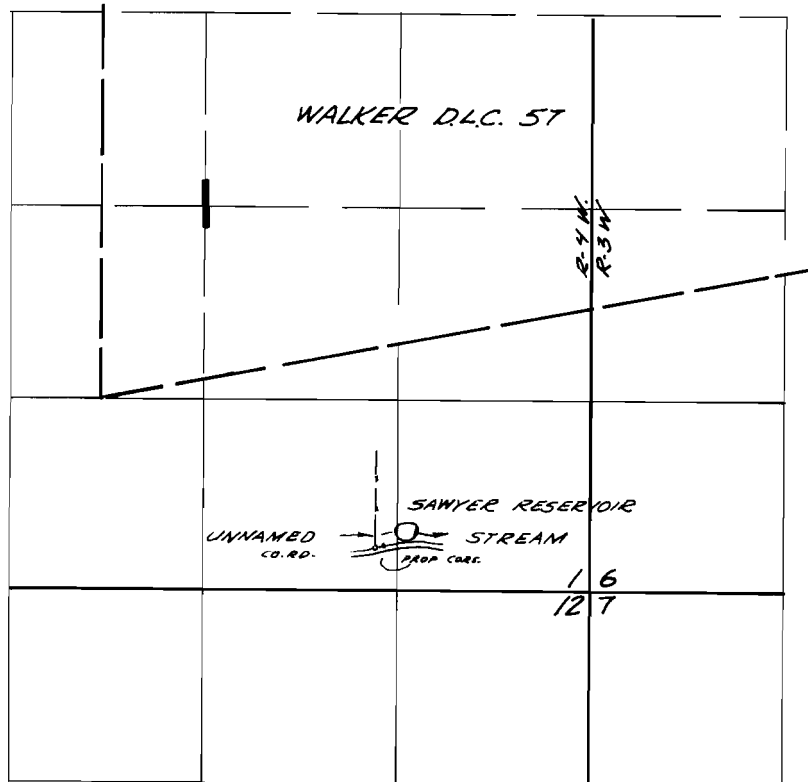

FINAL PROOF SURVEY
UNDER

Application No. *R-43/23* Permit No. *R-4920*
IN NAME OF

LAWRENCE SAWYER

Surveyed *Oct 16, 1968*, by *W. J. Ruppert*