


T.8S. R.6W. W.M.

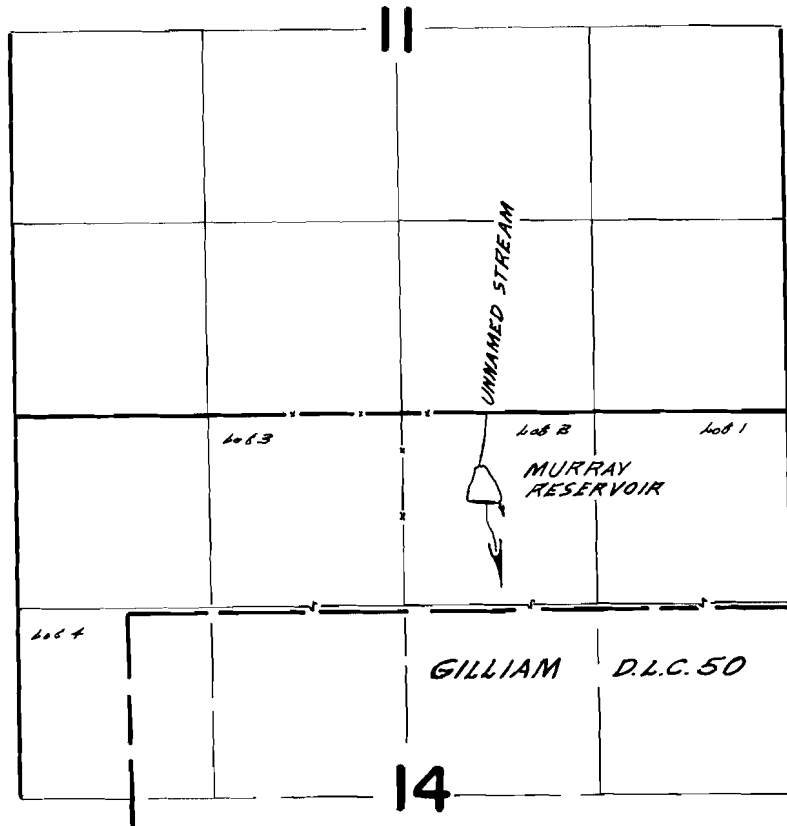

FINAL PROOF SURVEY
UNDER

Application No. *R-43134* Permit No. *R-4922*
IN NAME OF

PHILLIP MURRAY

Surveyed *Sept 9, 1968*, by *W. J. Kuipers*