


T. 8 S. R. 5 W. W.M.

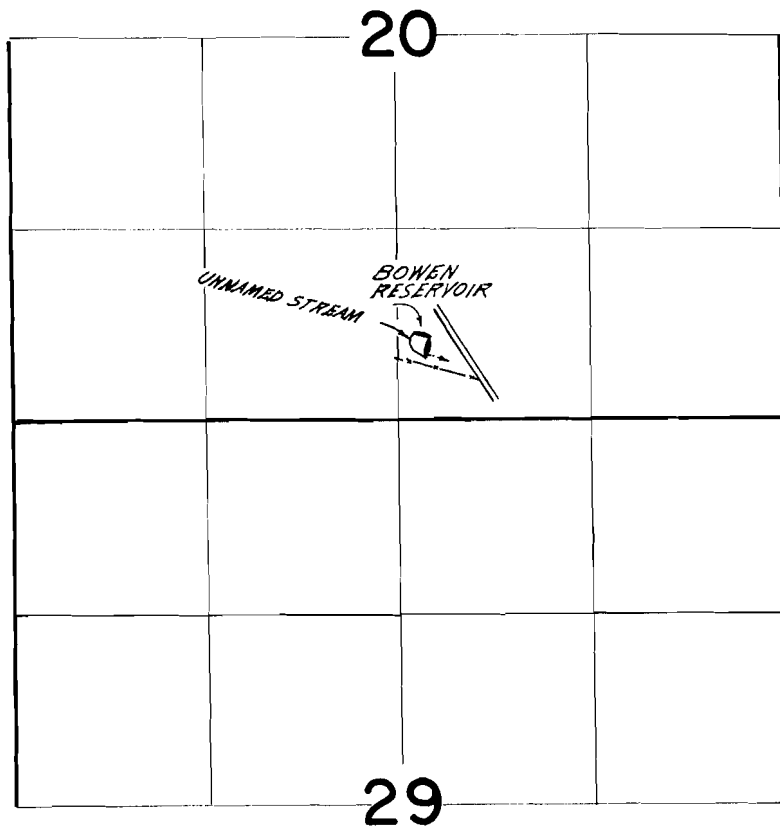

**FINAL PROOF SURVEY**  
UNDER

Application No. *R-43138* Permit No. *R-4924*  
IN NAME OF

*FRED BOWEN*

Surveyed *Sept 4* 1968, by *W.D. Supper*