


# T. 8 S. R. 6 W. W.M.

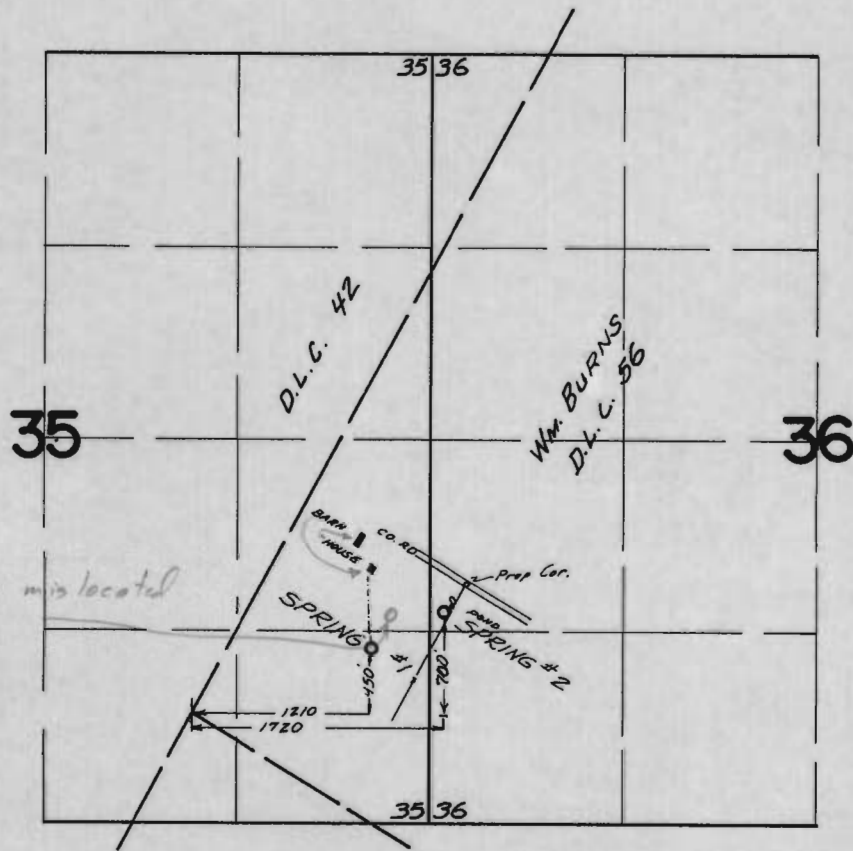

Apparently spring mislocated  
see file 48097

## FINAL PROOF SURVEY UNDER

Application No. 42146... Permit No. 31518...  
IN NAME OF

NORVAL EMBREE

Surveyed Sept. 26 1968, by W. J. Ruppert.