


T. 9 S. R. 5 W. W.M.

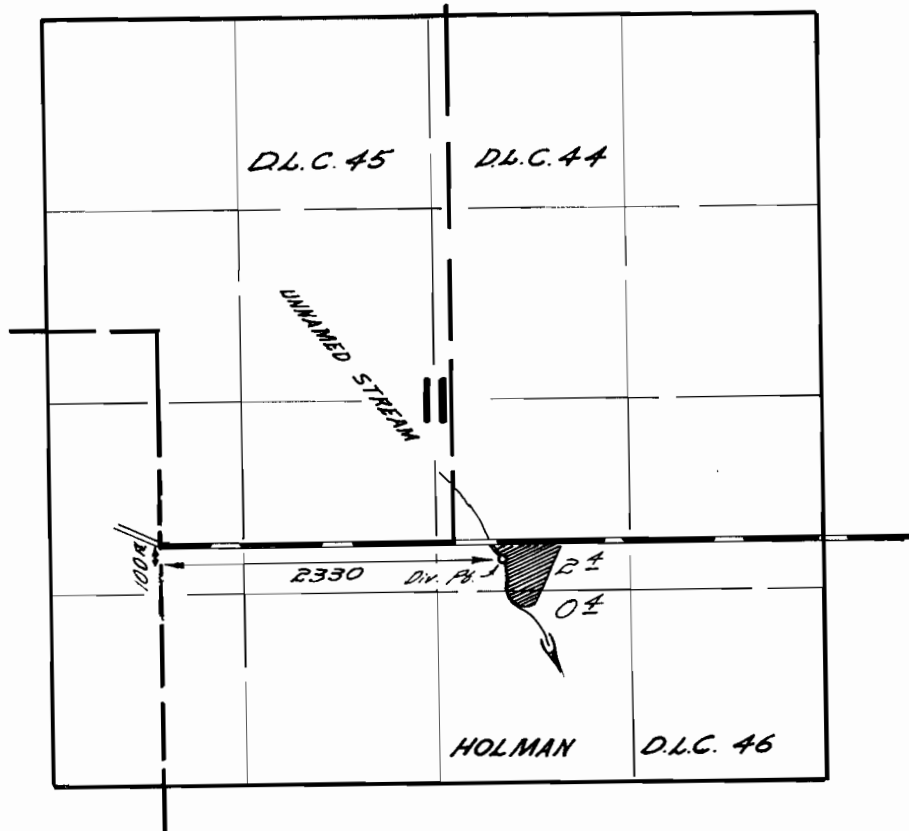

FINAL PROOF SURVEY
UNDER

Application No. *42766* Permit No. *31978*
IN NAME OF

MATTHEW R. THOMPSON

Surveyed *Sept 25, 1968*, by *Wd. Ruppert*