


T.9S. R.4W. W.M.

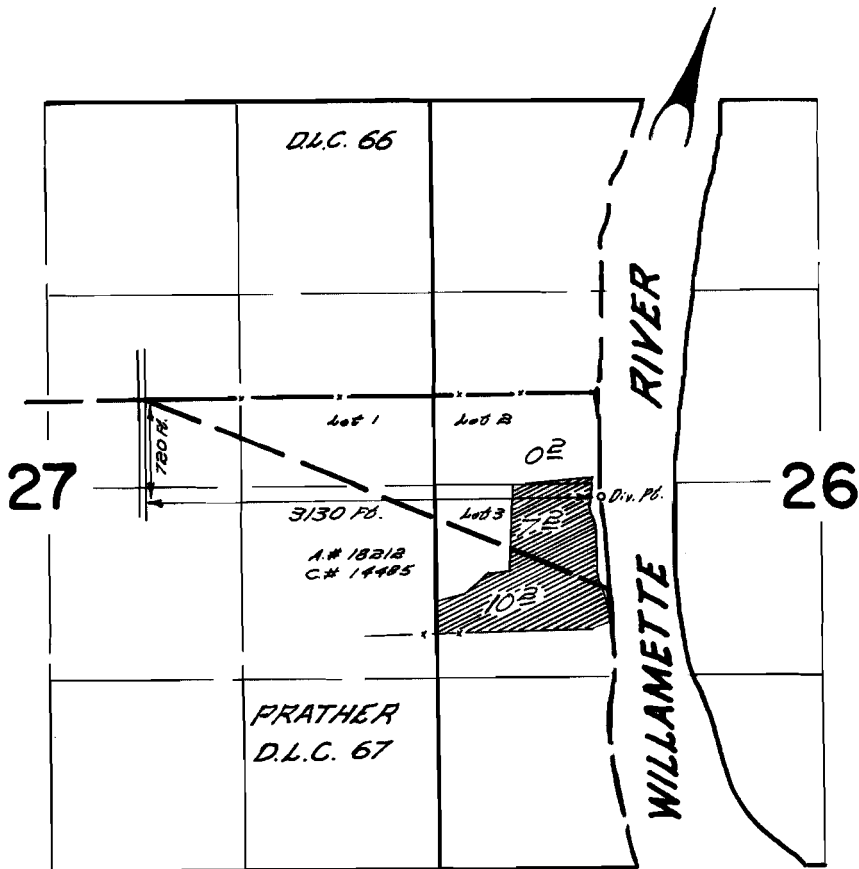

FINAL PROOF SURVEY
UNDER

Application No. 43379 Permit No. 32437
IN NAME OF

WARNER & LINN

Surveyed Aug 14 1968, by W. J. Ruppert