


T.35 S. R.38 & 39 E. W.M.

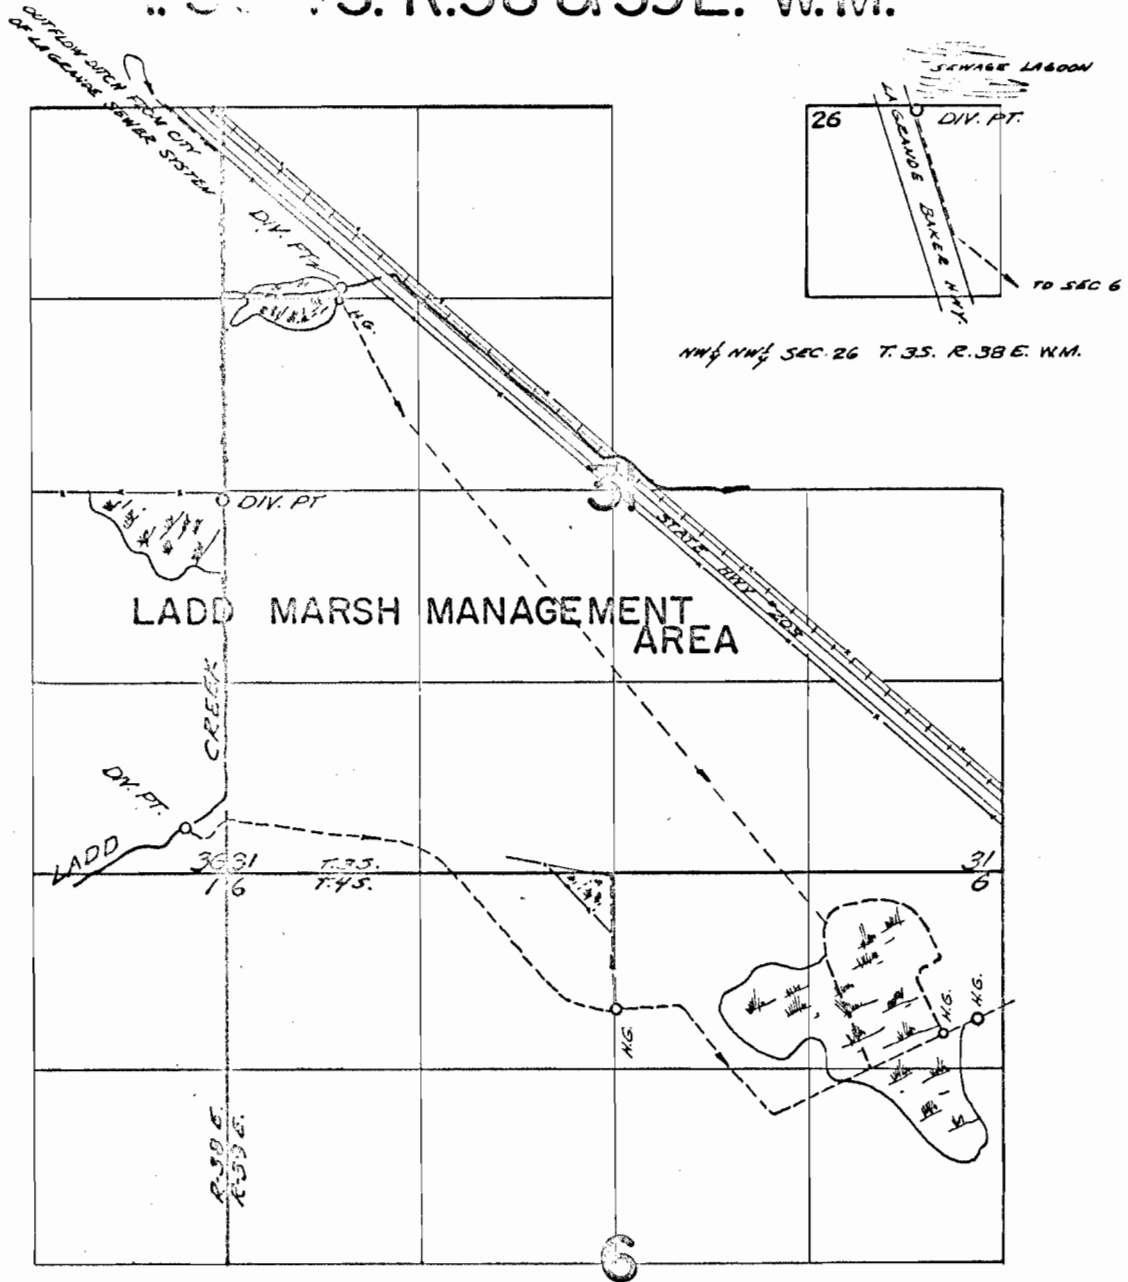

DIV. PTS. LOCATED:- 40 FT. S. & 740 FT. E. FROM THE NW. COR. SEC. 26;  
 1390 FT. N. & 790 FT. E.; 60 FT. S. & 10 FT. W. BOTH FROM THE W &  
 COR. SEC. 31; 320 FT. N. & 280 FT. W. FROM THE SE COR. SEC. 36

**FINAL PROOF SURVEY**  
 UNDER

37108                      27849  
 Application No. 40421... Permit No. 30208...  
 IN NAME OF

*OREGON STATE GAME COMMISSION*

Surveyed Aug 27... 1968, by *V. Garner*.....