


T.1 & 2 S.R.38 E, W.M.

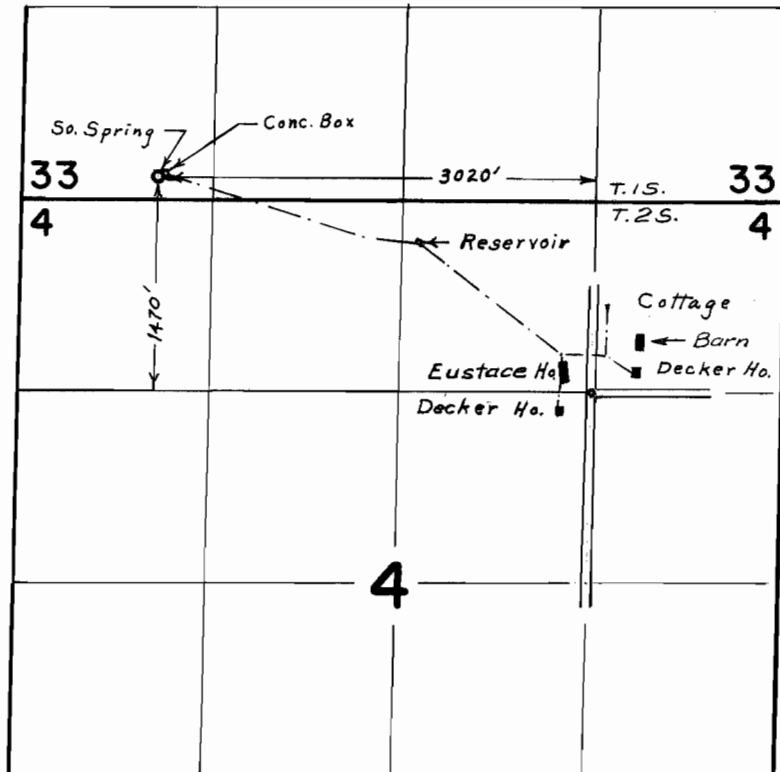

FINAL PROOF SURVEY UNDER

Application No. 38838 Permit No. 28995
IN NAME OF

DOROTHY M. & R. EDWARD SUMMERS

Surveyed Aug. 30, 1968, by L. E. Gould