


T. 3 S. R. 40 E. W.M.

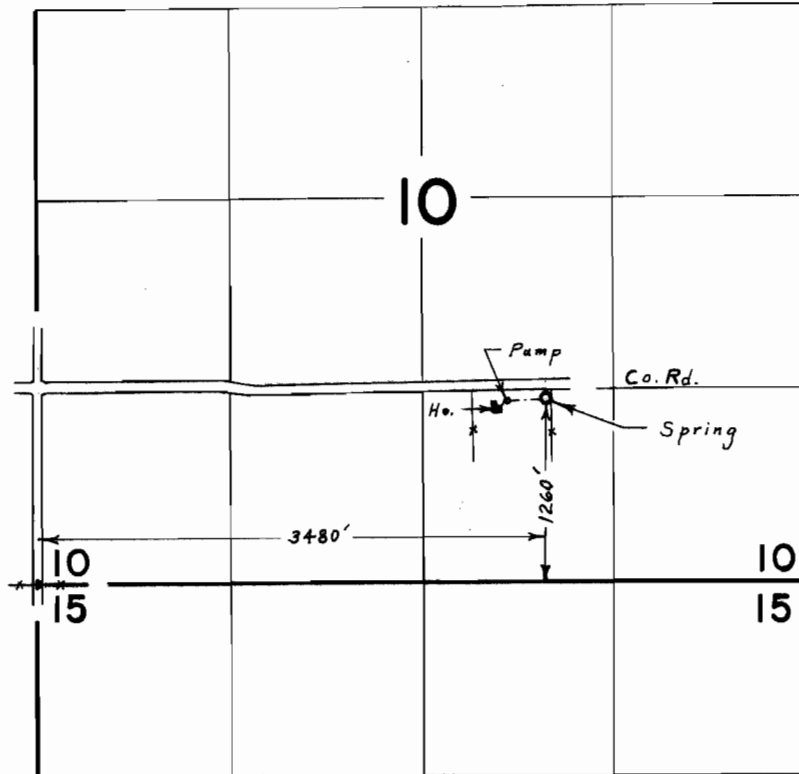

FINAL PROOF SURVEY UNDER

Application No. 38460 Permit No. 29337
IN NAME OF

BERNARD L. SHERWOOD

Surveyed Aug. 22, 1968, by L. E. Gould