


T.2 N. R.4 W. W.M.

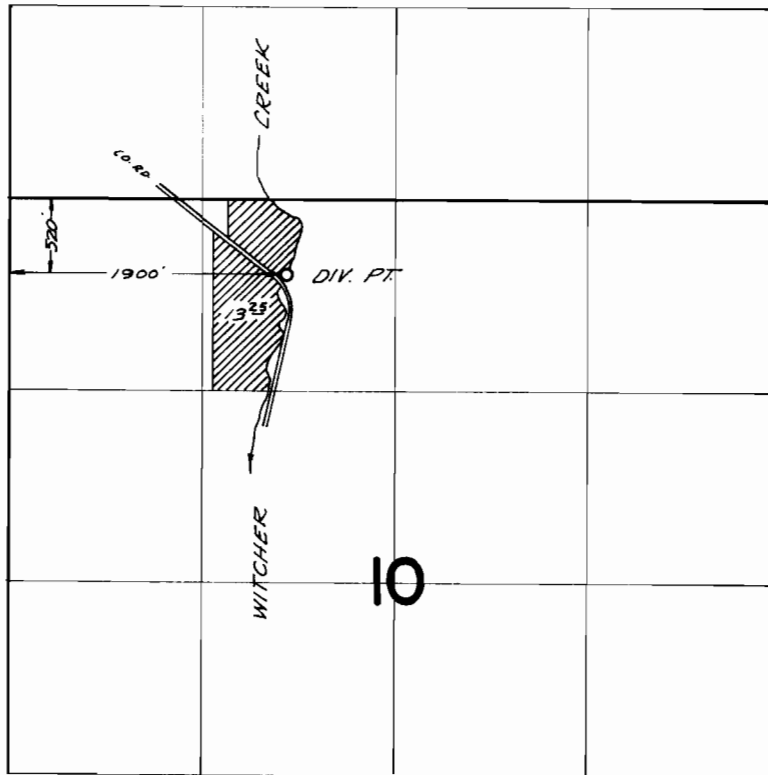

FINAL PROOF SURVEY
UNDER

Application No. 38357 Permit No. 28588
IN NAME OF

WILLIAM I. TOLKE

Surveyed June 27, 1968, by V. Garner