


# T.1N. R.3W. W.M.

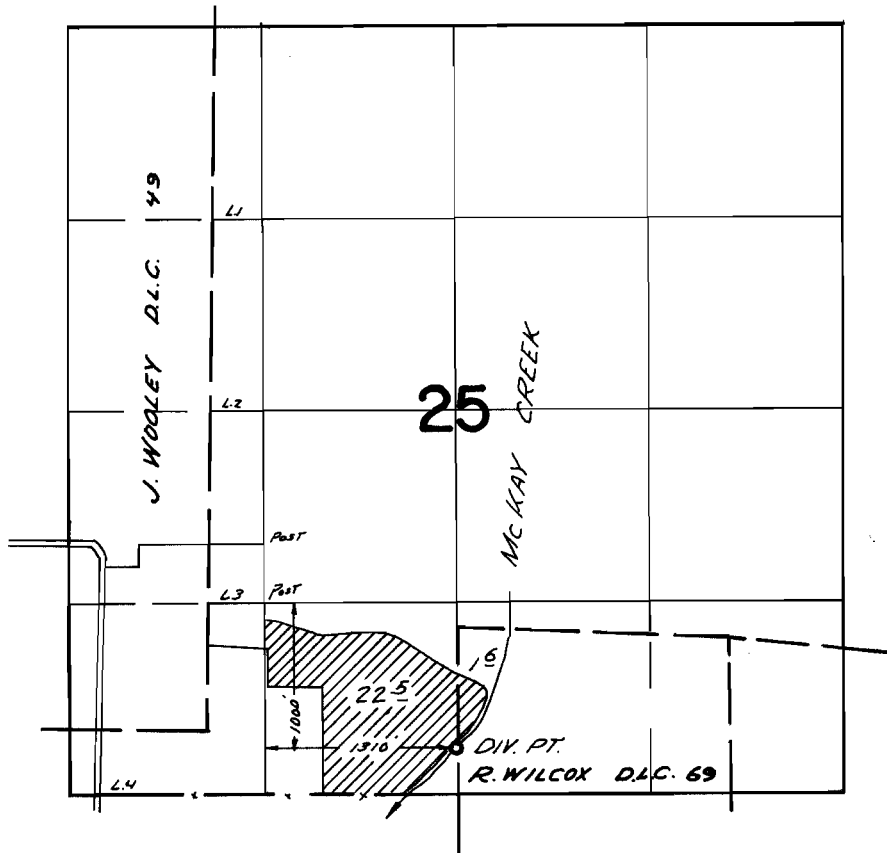

## FINAL PROOF SURVEY UNDER

Application No. 39925 Permit No. 29716  
IN NAME OF

*RAYMOND & BEATRICE WAIBEL*

Surveyed June 26 1968, by *V. GARNER*