


T. 1 N. R. 3 W. W.M.

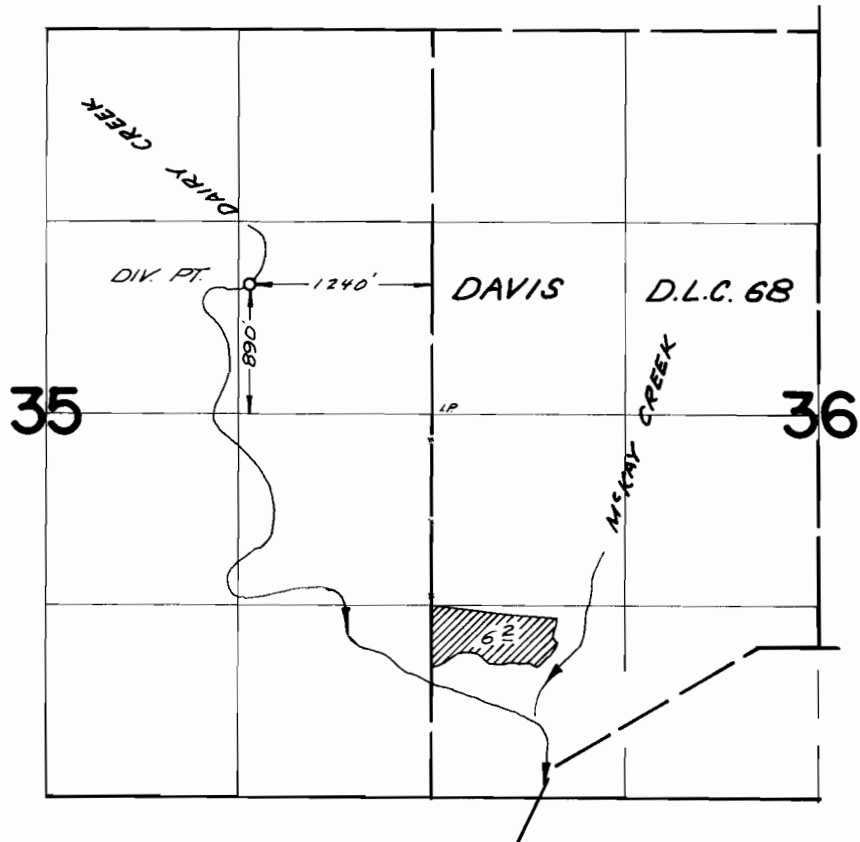

FINAL PROOF SURVEY
UNDER

Application No. 41726 Permit No. 31203
IN NAME OF

RAYMOND HERTEL

Surveyed June 26 1968, by V. Garner