


T.2 N. R.4 W. W.M.

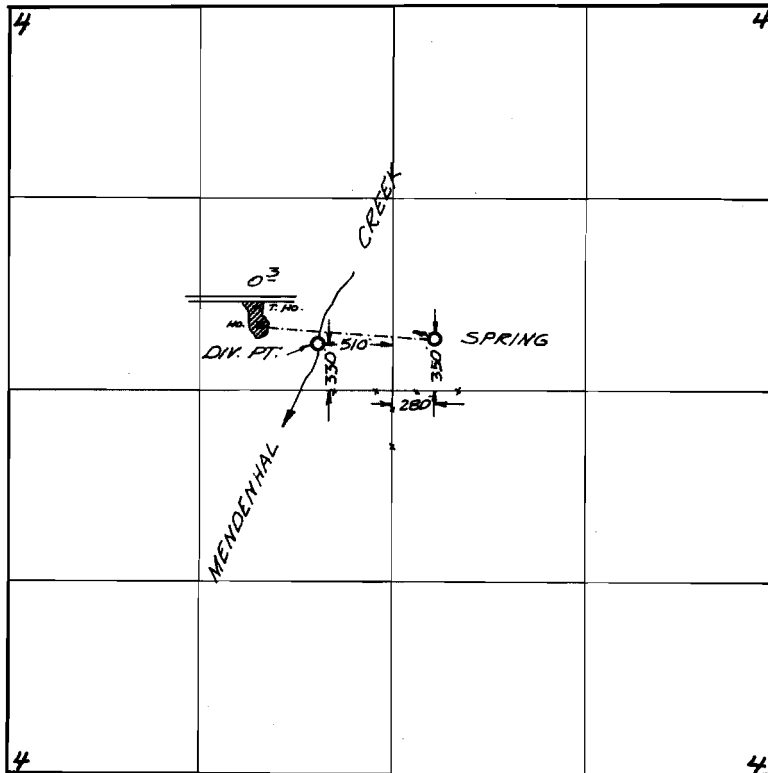

FINAL PROOF SURVEY
UNDER

Application No. 43610 Permit No. 32611
IN NAME OF

JOHN LOUIS CURTIS

Surveyed JUNE 27 1968, by V. Garner