


# T. 1 S. R. 4 W. W. M.

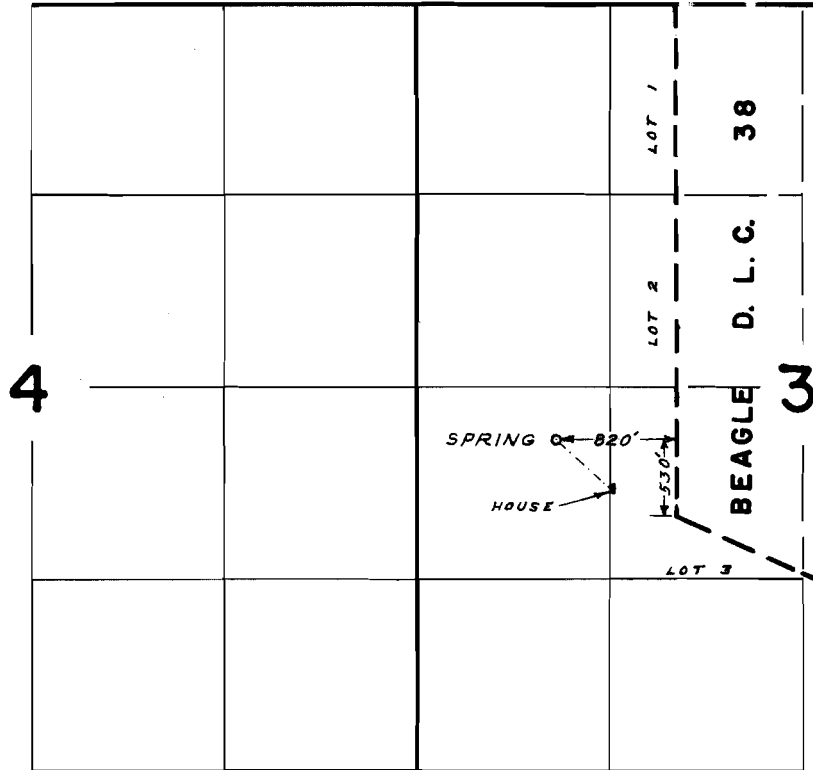

## FINAL PROOF SURVEY UNDER

Application No. 43982 Permit No. 32881  
IN NAME OF

DAVID W. & MARY E. EASTON

Surveyed OCT. 7, 1968, by W. J. RUPPERT