


# T. 14 S. R. 6 W. W. M.

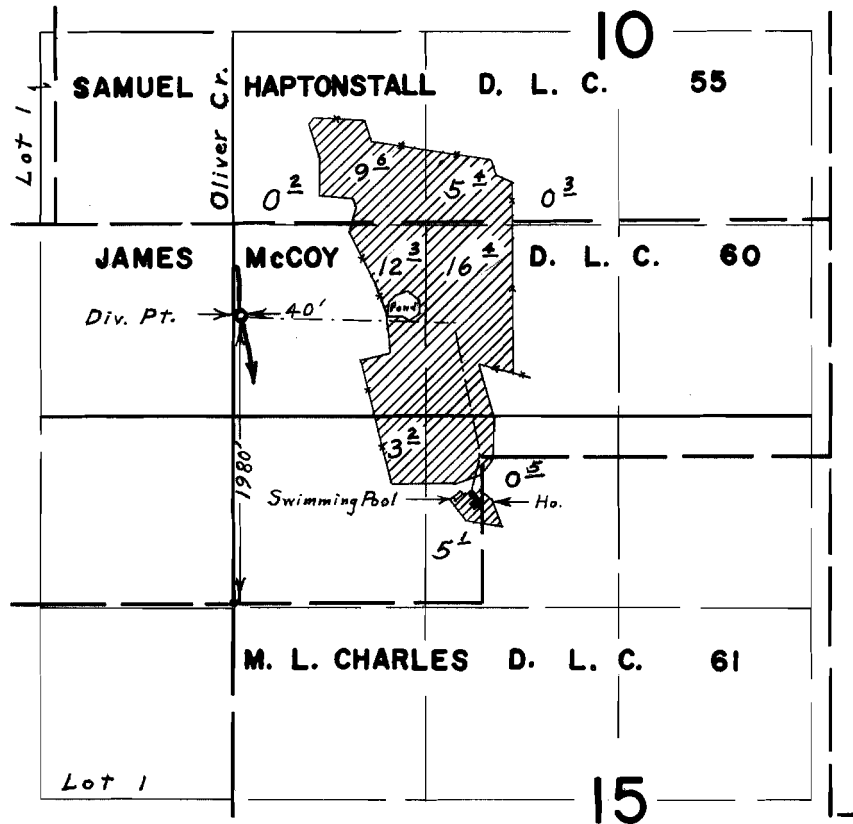

## FINAL PROOF SURVEY UNDER

Application No. 4037B... Permit No. 30103...  
IN NAME OF

HULL LUMBER COMPANY, INC.

Surveyed NOV. 14, 1968, by W. J. Ruppert