


T.13S.R.5W.W.M.

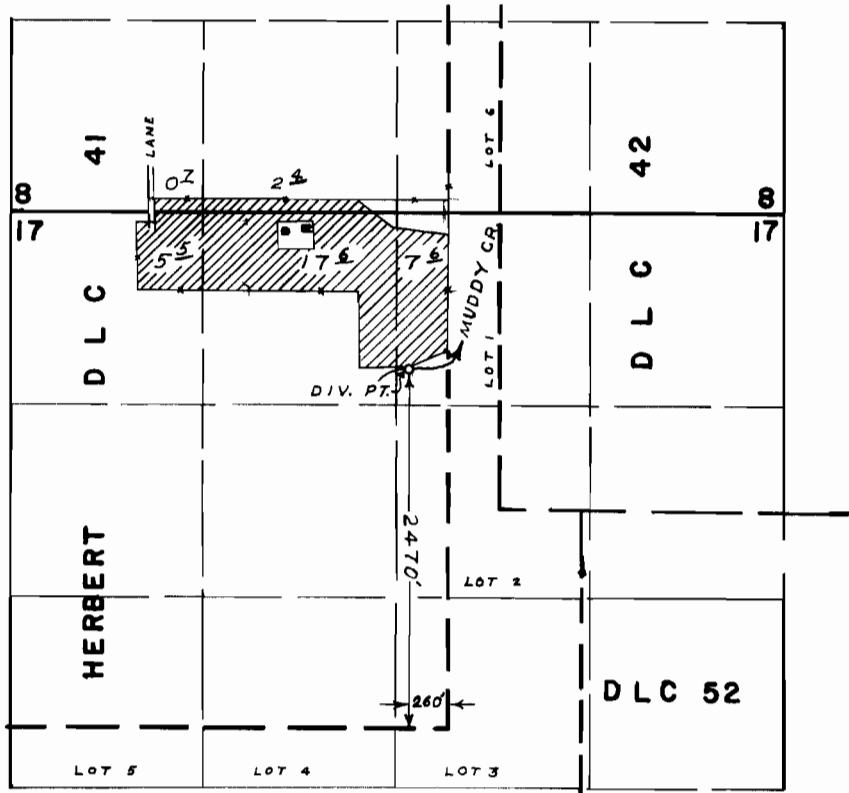

FINAL PROOF SURVEY UNDER

Application No. **43256** Permit No. **32336**
IN NAME OF

EDMUND G. COOMES

Surveyed **SEPT. 24 1968**, by **L. E. GOULD**