


T.4S. R.1E.W.M.

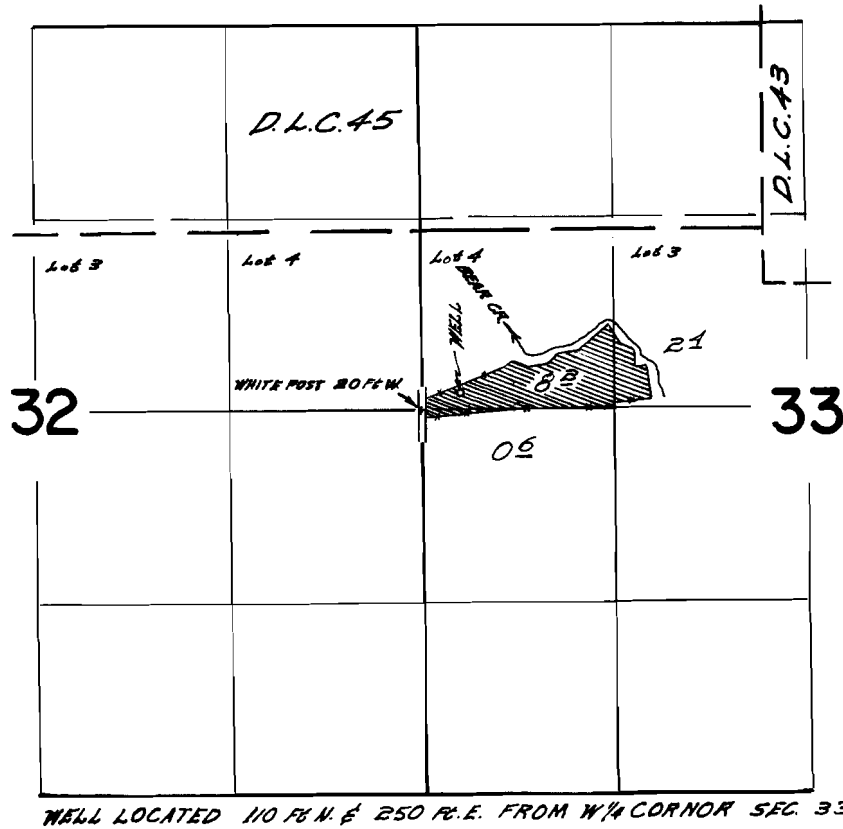

FINAL PROOF SURVEY
UNDER

Application No. G-2990. Permit No. G-2781.
IN NAME OF

J. R. CLACK

Surveyed June 21, 1968, by W. J. Ruppert