


T.4S. R.1E.W.M.

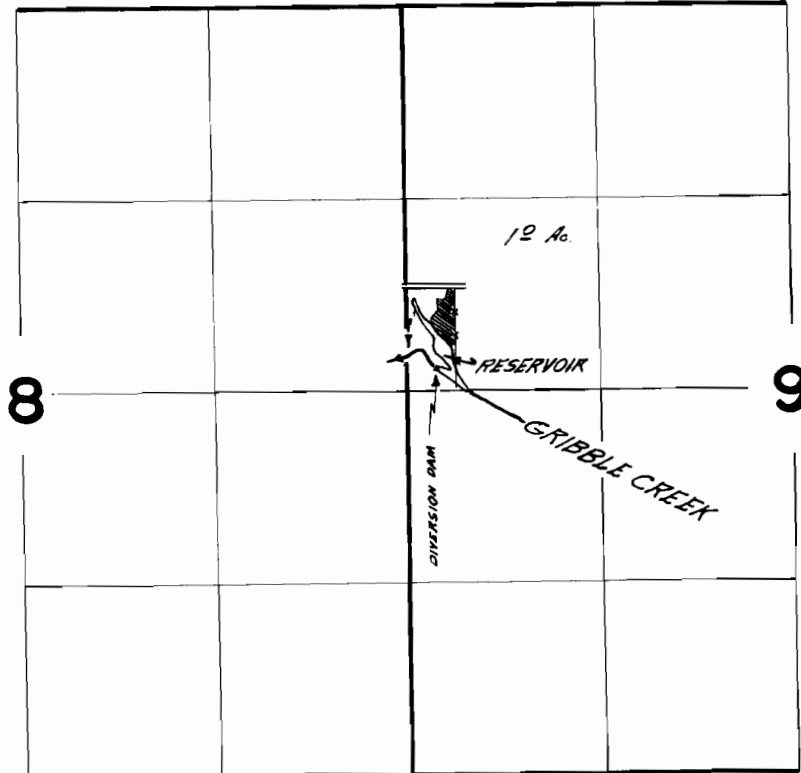

DIVERSION POINT LOCATED 150 FE. N. & 210 FE. E. FROM W¹/₄ CORNER SECTION 9

FINAL PROOF SURVEY
UNDER

R-42038 R-4782
Application No. 42039 Permit No. 31468
IN NAME OF

LYLE KERN

Surveyed 6-21 1968, by W. d. Ruppert