


# T.4S. R.1E. W.M.

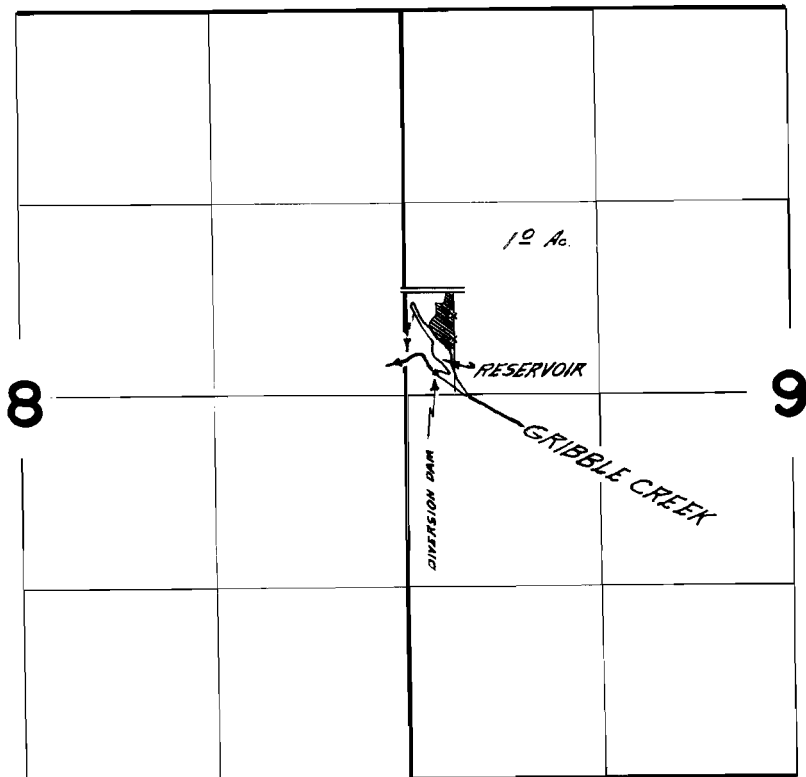

DIVERSION POINT LOCATED 150 FE. N. & 210 FE. E. FROM W<sup>1</sup>/<sub>4</sub> CORNER SECTION 9

## FINAL PROOF SURVEY UNDER

R-42038                      R-4782  
Application No. 42039    Permit No. 31468  
IN NAME OF

**LYLE KERN**

Surveyed 6-21-1968, by W. J. Ruppert