


T.38&4S. R.1&2E.W.M.

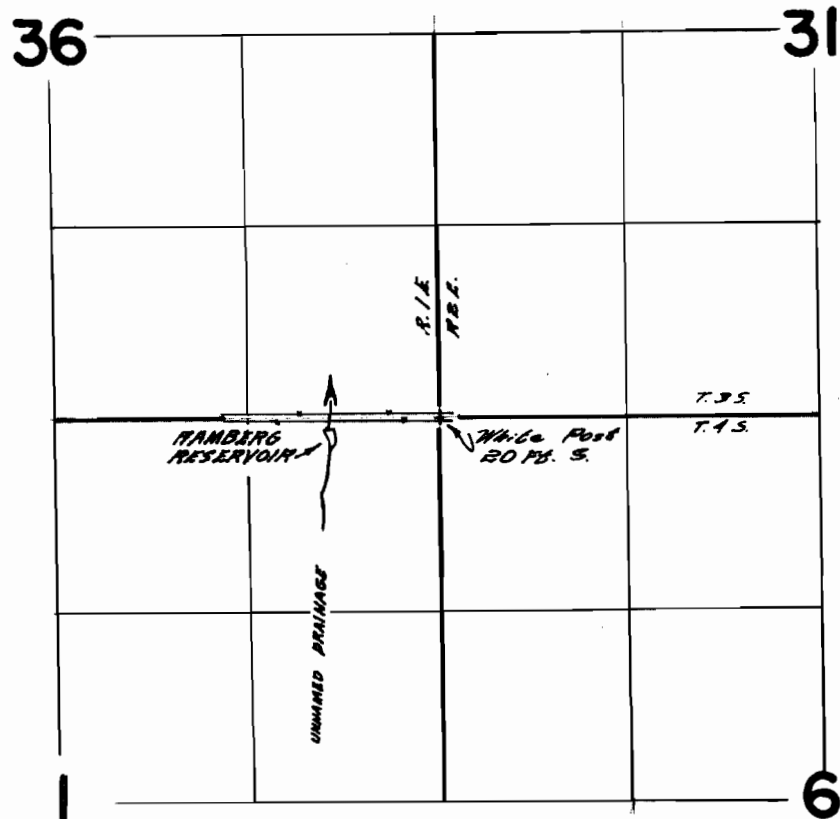

FINAL PROOF SURVEY
UNDER

Application No. *R-43133* Permit No. *R-4921*
IN NAME OF

HAROLD C. RAMBERG

Surveyed *July 3* 1968, by *W. S. Fuppert*