


T.28 S.R.12 W.W.M.

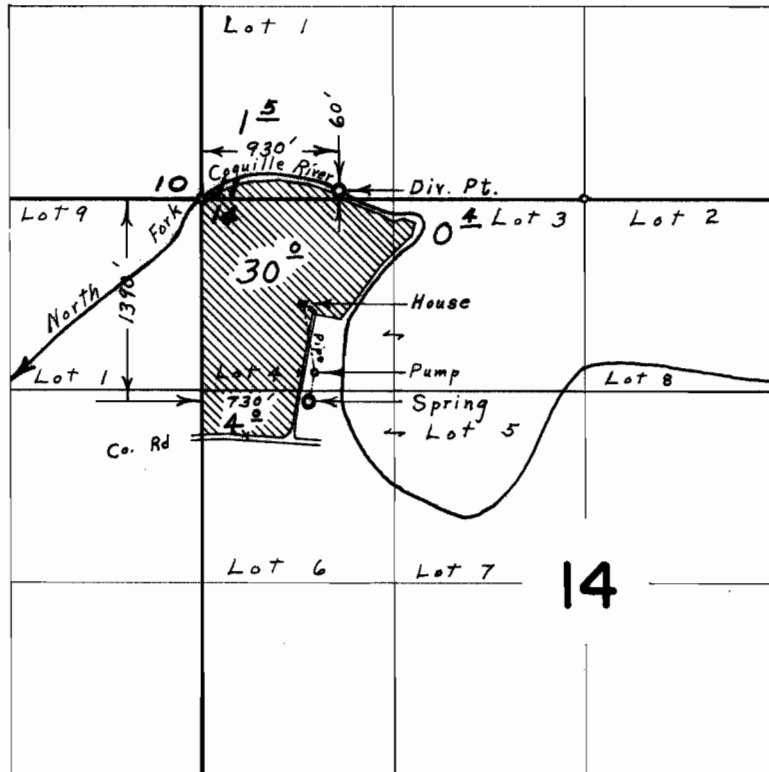

FINAL PROOF SURVEY UNDER

Application No. 39631 Permit No. 29448
IN NAME OF

CARL B. & LILA B. HOLLAND, JR.

Surveyed May 24, 1967, by L. E. Gould