


T. 26 S. R. 6 W. W.M.

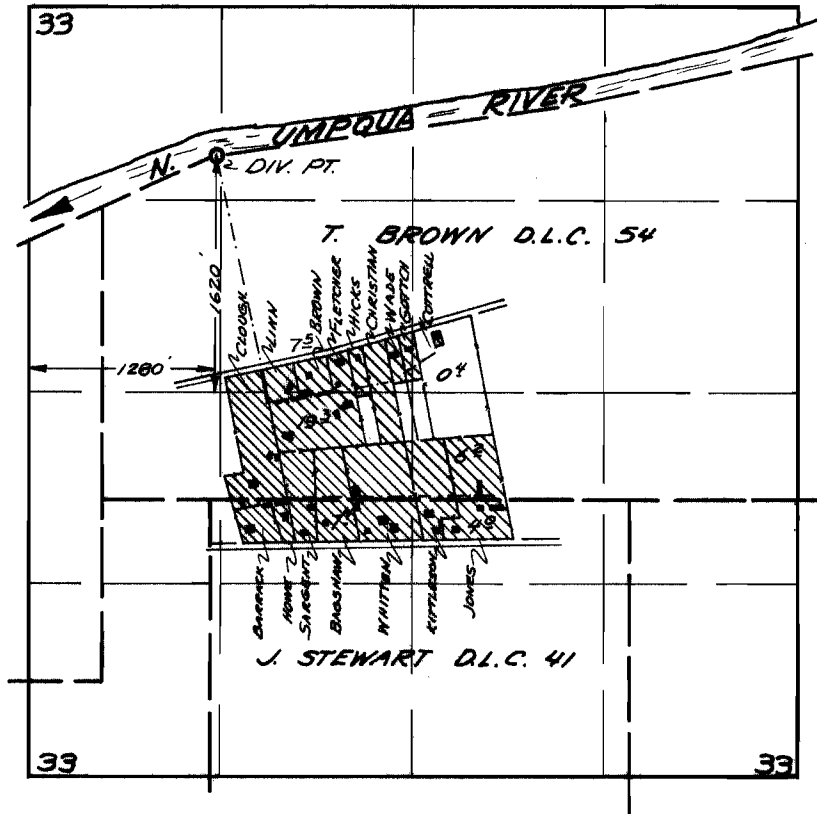

FINAL PROOF SURVEY UNDER

Application No. 39645. Permit No. 29523.
IN NAME OF

RIVERSIDE COMMUNITY WATER SYSTEM

Surveyed Oct. 2, 1968, by *V. Garner*