


T.13S. R.31E.W.M.

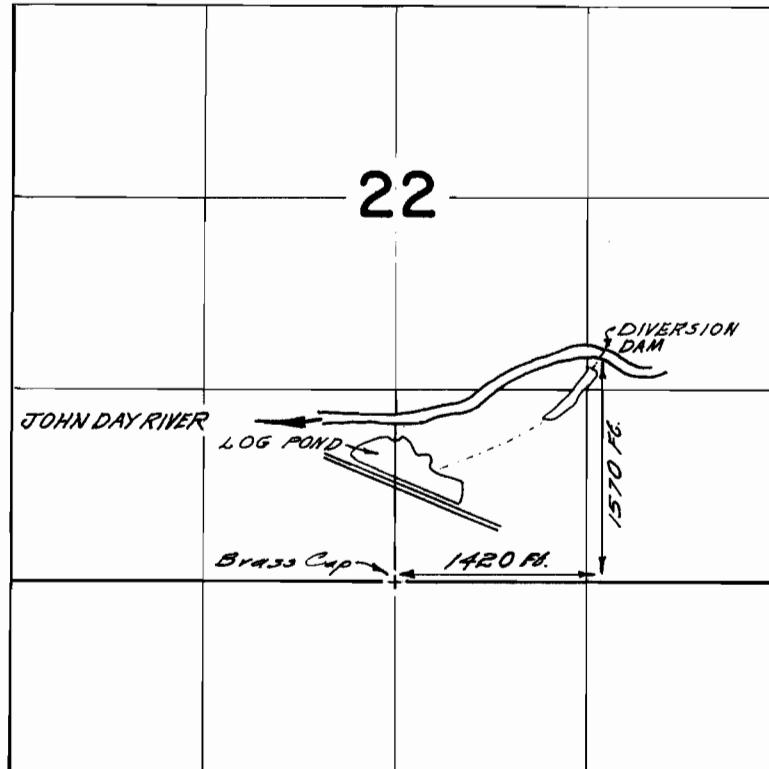

FINAL PROOF SURVEY
UNDER

R-38798 R-3287
Application No. 38092 Permit No. 28872
IN NAME OF

SAN JUAN LUMBER CO., INC.

Surveyed July 9, 1968, by *W. J. Ruppert*