


28872

36368

T.13S. R.31E.W.M.

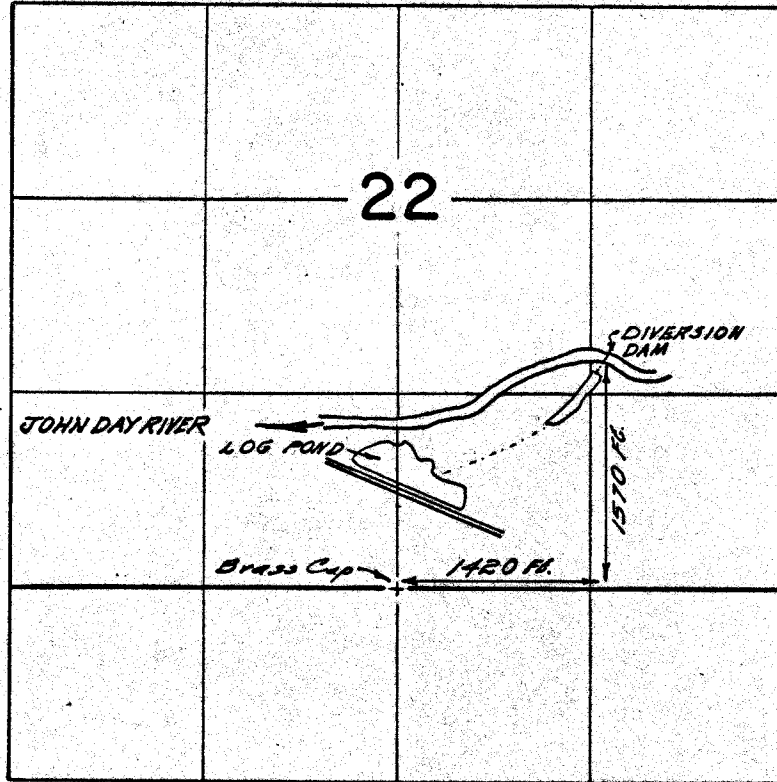

**FINAL PROOF SURVEY**  
UNDER

R-38798      R-3287  
Application No. 36092      Permit No. 28872  
IN NAME OF

**SAN JUAN LUMBER CO., INC.**

Surveyed July 9, 1968, by *W. D. Reppert*