


T.37S. R.9E. W.M.

Upper Klamath alk. wells

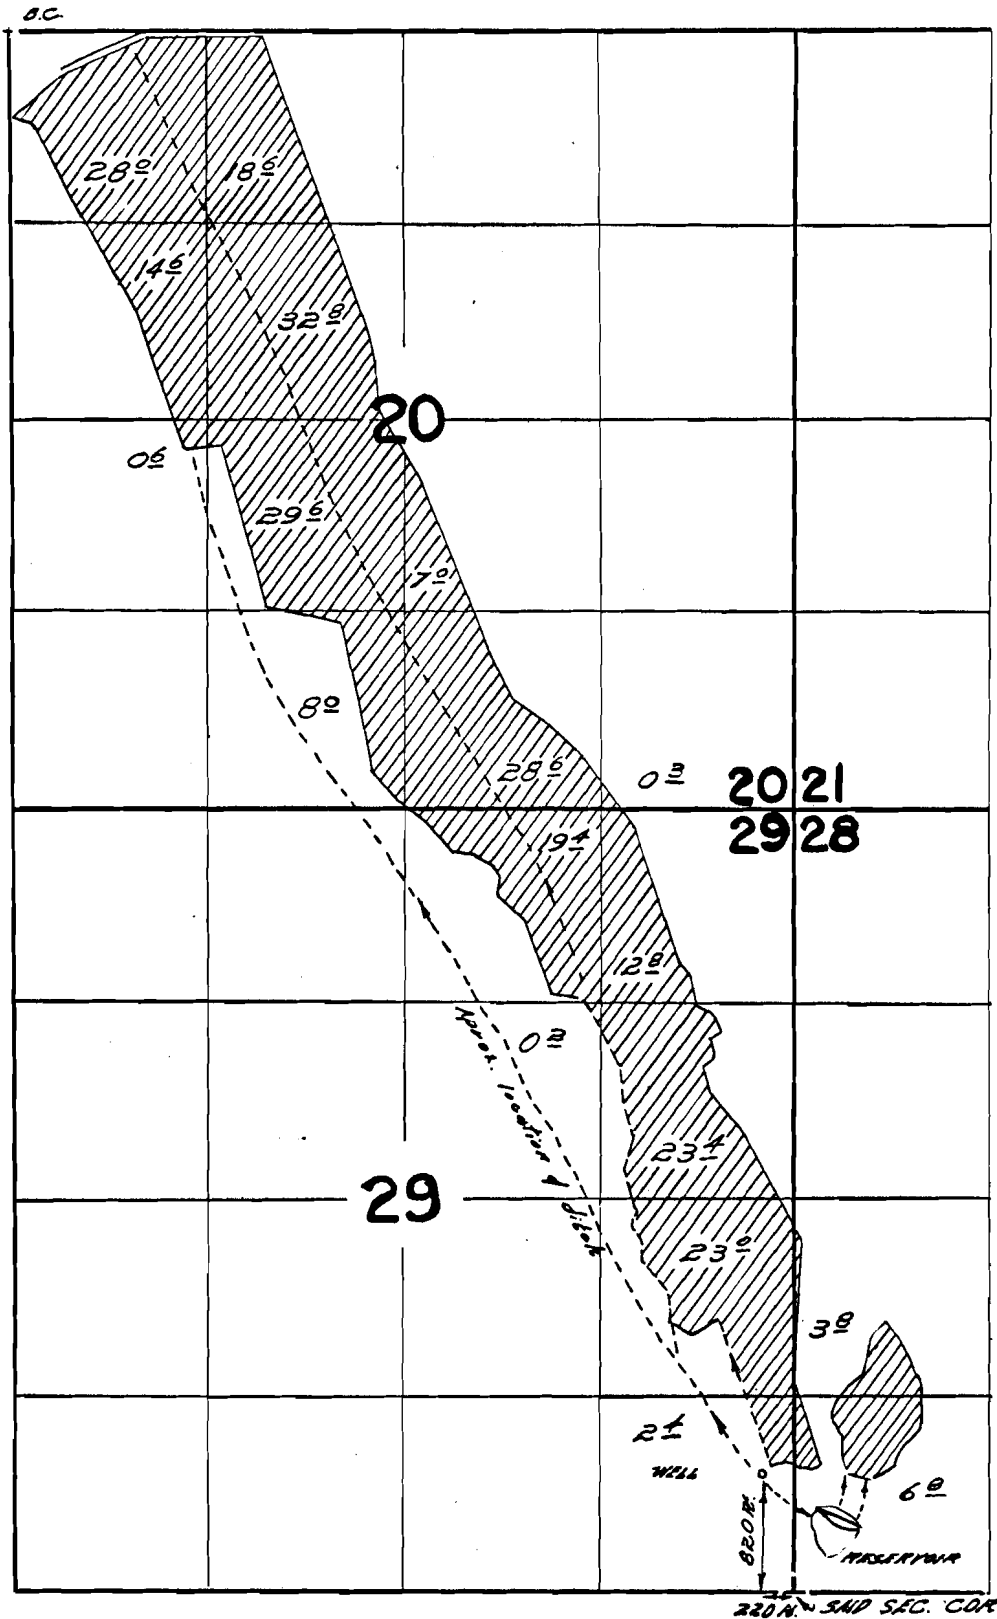

FINAL PROOF SURVEY

UNDER

Application No. G-2040 Permit No. G-1875

IN NAME OF

LEWIS HAGEMSTEIN