


20066  
R-2451  
36371

# T. 39 S. R. 13 E. W. M.

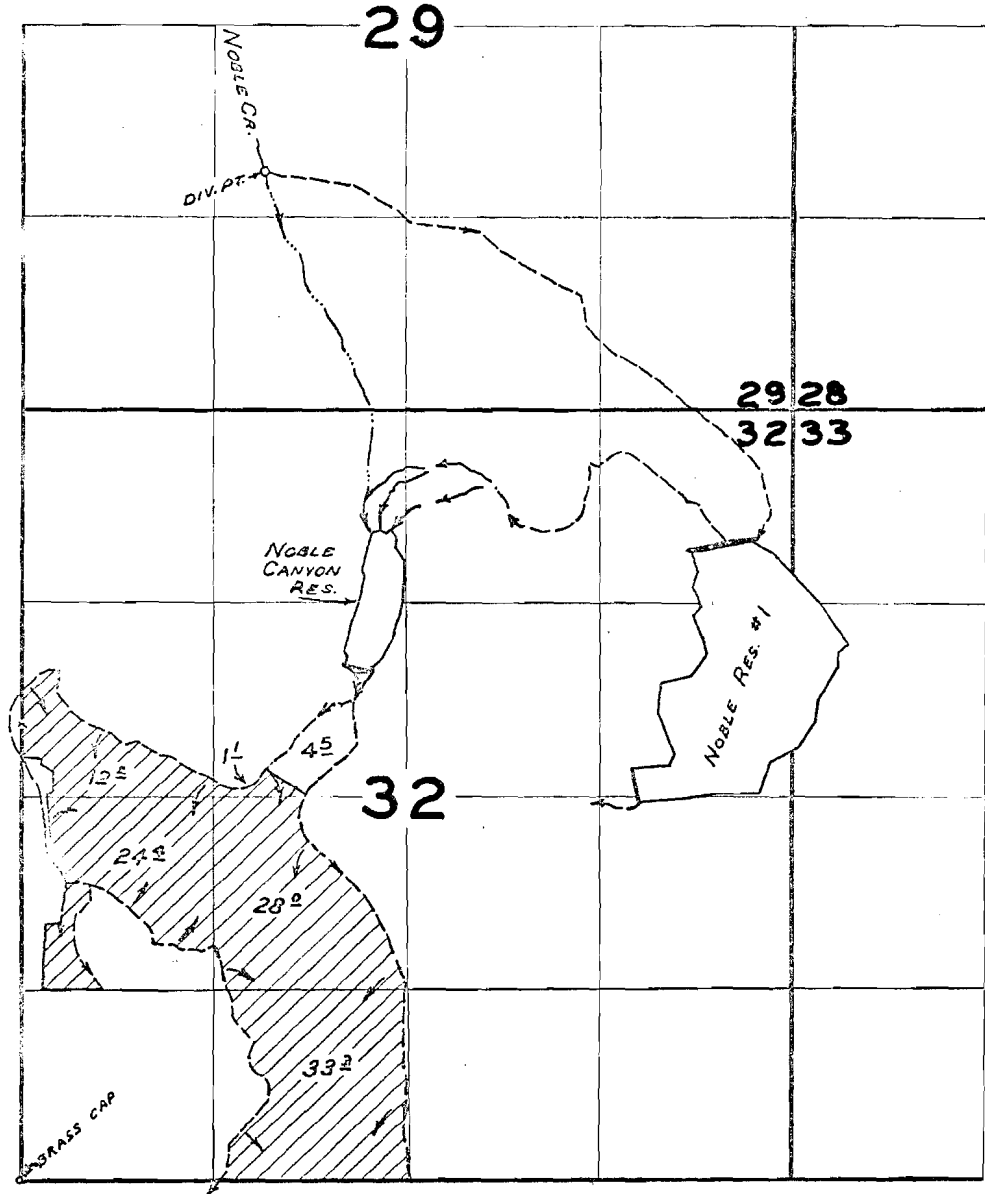

Miller Creek & Misc.

## FINAL PROOF SURVEY UNDER

Application No. <u>R-28975</u>	Permit No. <u>R-2306</u>
<u>28976</u>	<u>26482</u>
<u>R-33703</u>	<u>R-2451</u>
<u>33704</u>	<u>26866</u>

IN NAME OF

**ELDEN & VIRGINIA KENT**

Surveyed JUL 27 1964, by R. JACKSON