


T.39S.R.13E.W.M.

26866
34372

Miller Co. : Misc.

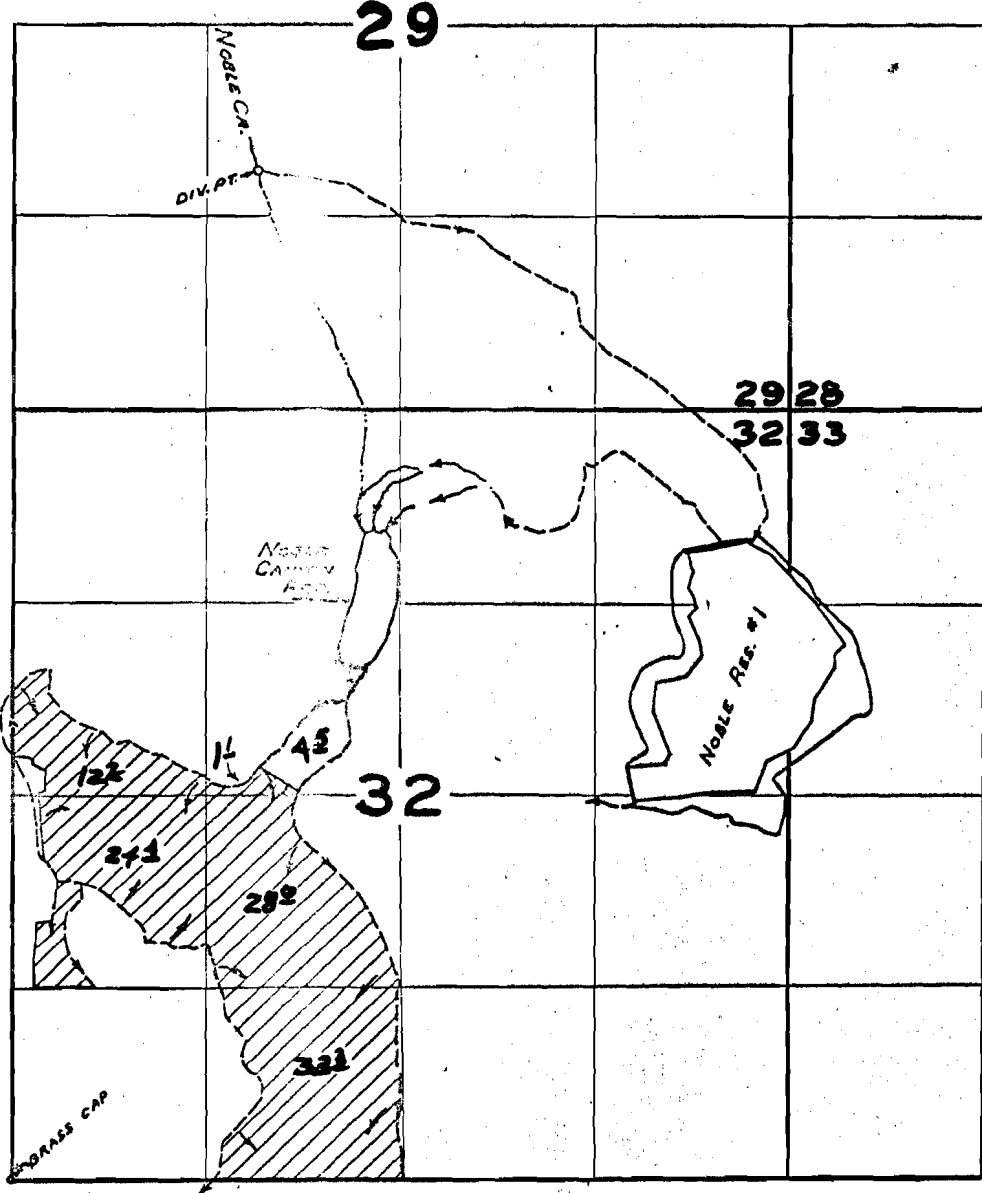

FINAL PROOF SURVEY
UNDER

Application No. *R-28975* Permit No. *R-2306*
28976 *26482*
R-33703 *R-2451*
33704 *26866*

IN NAME OF
ELDEN & VIRGINIA KENT

Surveyed Jul. 27 1964 by R. JACKSON
June 4, 1967 *W.J. Fyppard*