


R-2306  
36373

T. 39 S. R. 13 E. W. M.

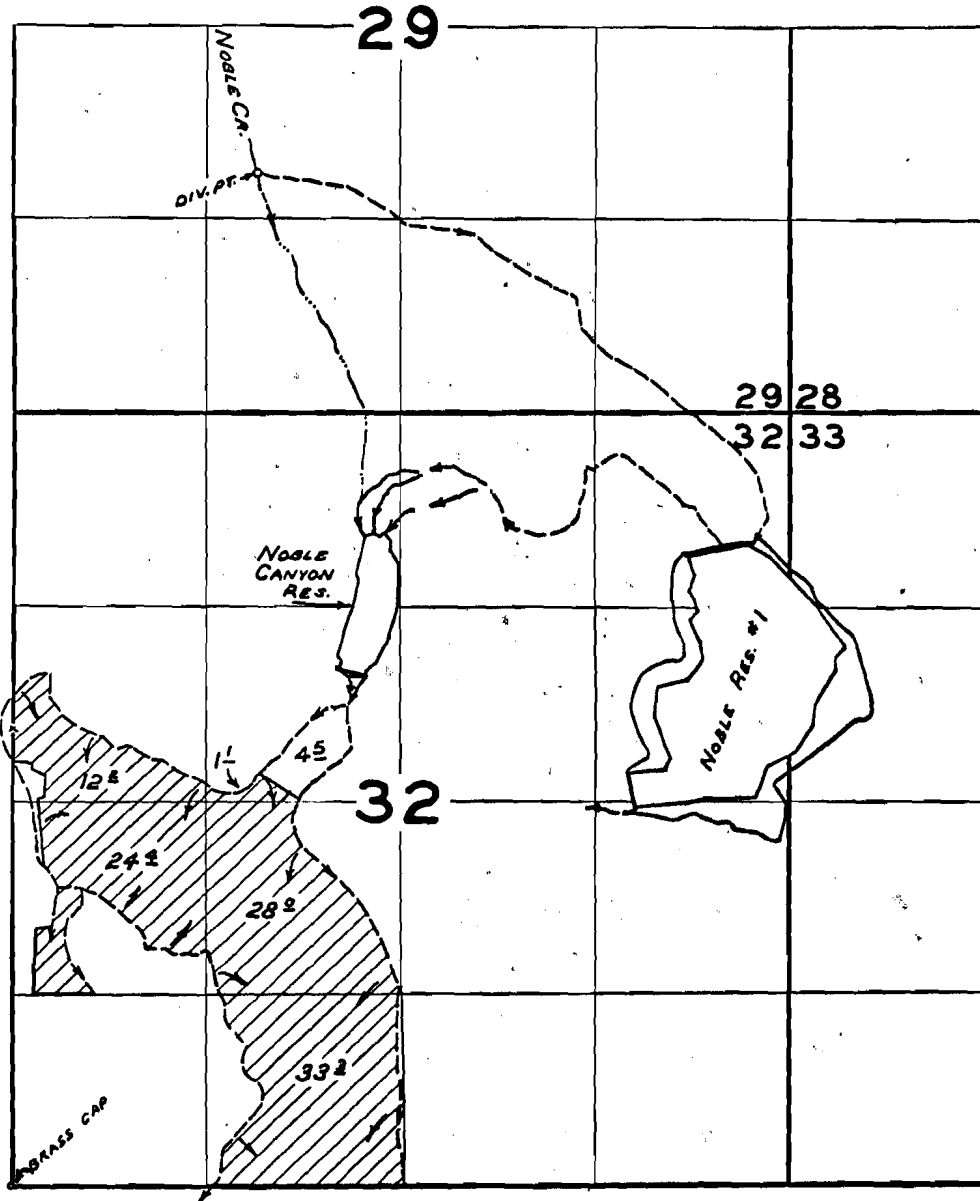

mine site : misc.

**FINAL PROOF SURVEY**  
UNDER

Application No.	R-28975 28976 R-33703 33704	Permit No.	R-2306 26482 R-2451 26866
-----------------	--------------------------------------	------------	------------------------------------

IN NAME OF

**ELDEN & VIRGINIA KENT**

Surveyed Jul. 27, 1964 by R. JACKSON  
June 4, 17 1969 W.J. Pappard