


26482  
36374

T. 39 S. R. 13 E. W.M.

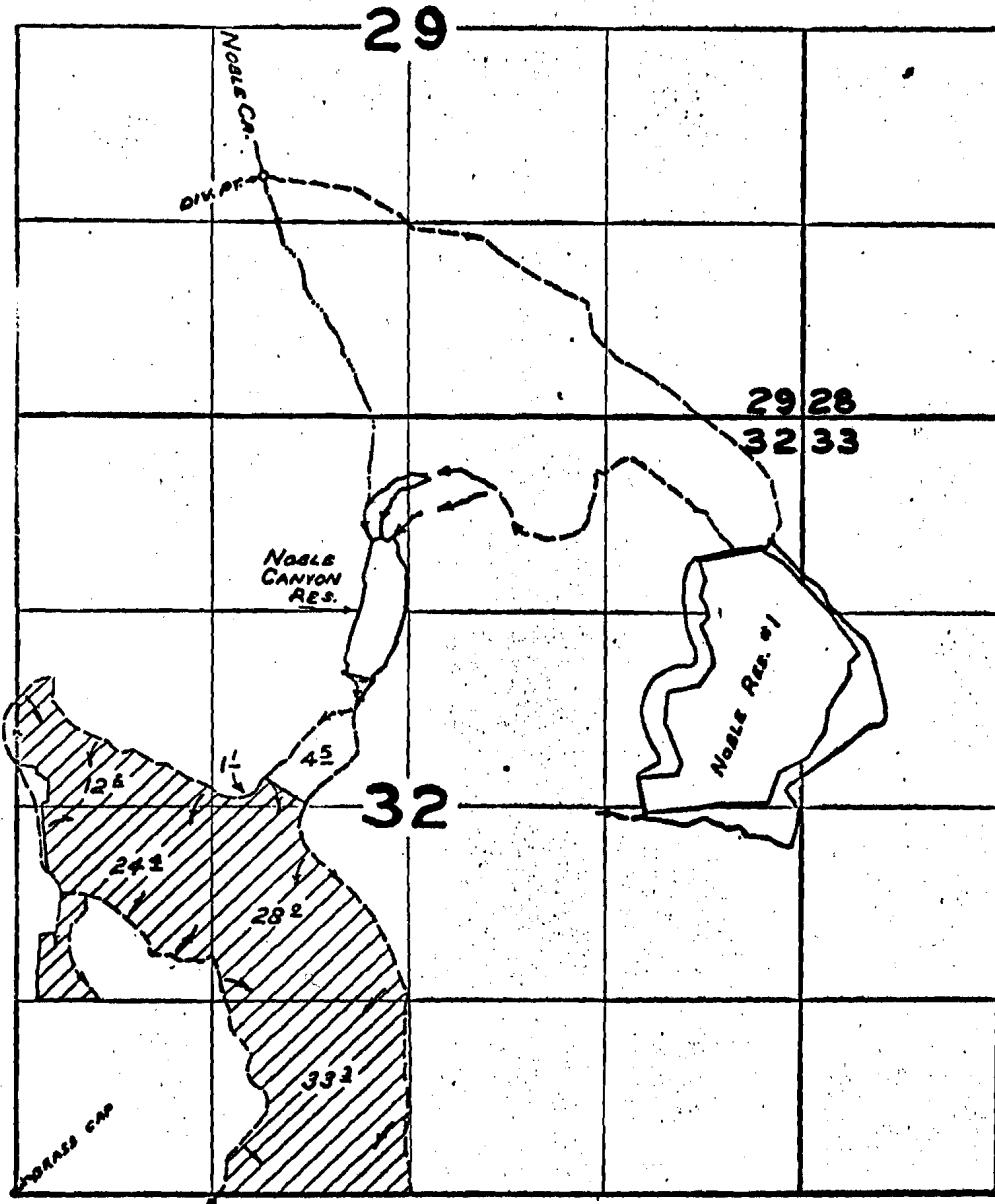

FINAL PROOF SURVEY  
UNDER

R-28975  
28976  
R-33703

R-2306  
26482  
R-2451

Application No. 33704 Permit No. 26866  
IN NAME OF

ELDEN & VIRGINIA KENT

Surveyed Jul. 27 1964 by A. JACKSON  
June 16 1969 J. D. Ryppord