


27672
36375

T. 34S. R. 9E. W.M.

Sprague Co. moe.

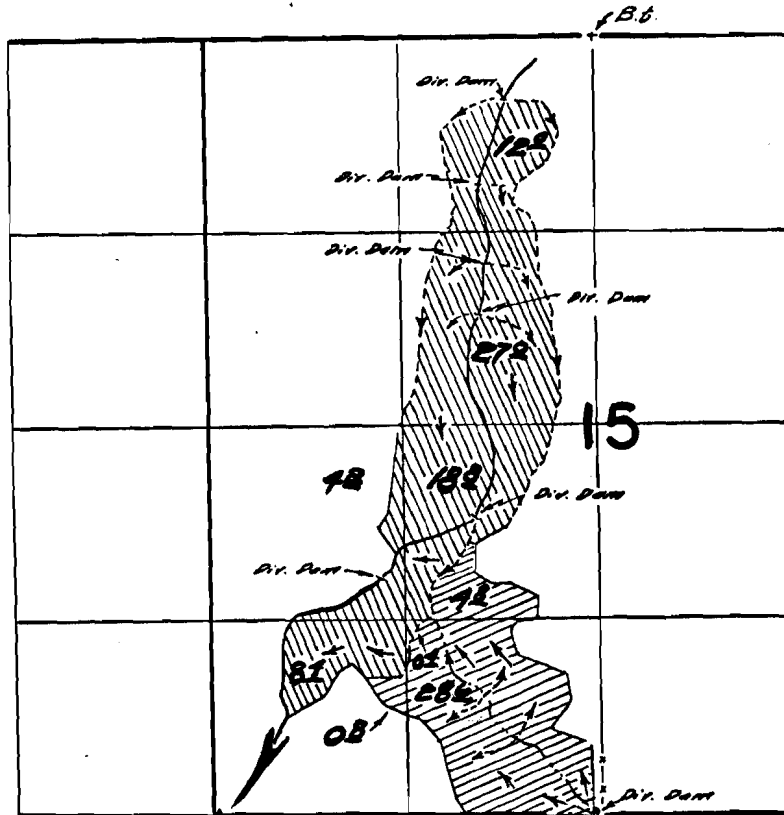

UNNAMED STREAM

DIVERSION POINTS LOCATED
 430 FT. S. & 610 FT. W.
 1010 FT. S. & 780 FT. W.
 1540 FT. S. & 750 FT. W.
 1900 FT. S. & 800 FT. W.
 3270 FT. S. & 830 FT. W.
 3680 FT. S. & 1470 FT. W.
 FROM N¹/₄ Cor. Sec. 15.
 80 FT. N. & 40 FT. W.
 FROM S¹/₄ Cor. Sec. 15

UNNAMED STREAM

FINAL PROOF SURVEY UNDER

Application No. 37149.. Permit No. 27672
IN NAME OF

DAYTON O. GERDAY HYDE

Surveyed August 22 1968, by W. d. Fugger 15..